

STATE OF MICHIGAN
DEPARTMENT
OF
NATURAL RESOURCES

LAND CORNER RECORD


MASON COUNTY
T 18 N R 15 W

DESCRIPTION OF CORNER Center of SE 1/4 of Sec. 24

CORNER MONUMENT Set 1"x36" pipe & Cedar guard post w/location tag

DATE MONUMENT PLACED AND WITNESSED 5-18-1972

WITNESSES TO CORNER..... _____

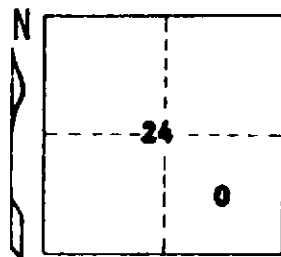

W. Pine 19" S 25 E 39.43'

E. Pine 16" N 20 E 6.30'


AND

Exist. 1" Pipe S 40 W 21.8'

CIRCLE CORNER REGISTERED

DESCRIPTION IN DETAIL AS TO HOW CORNER WAS LOCATED AND IDENTIFIED OR RESTORED.

Established corner per standard B.L.M. instructions.

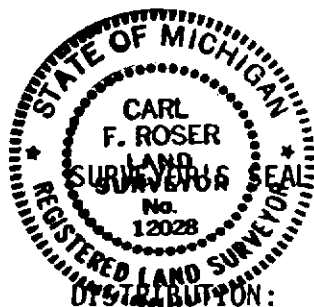

SIGNED

Carl F. Roser

DATE

5-25-72

REGISTERED LAND SURVEYOR 12028

Forestry Division, Lansing