

STATE OF MICHIGAN  
DEPARTMENT  
OF  
NATURAL RESOURCES

LAND CORNER RECORD


MASON COUNTY  
T 18 N R 15 W

DESCRIPTION OF CORNER E 1/16 on S. line Sec. 24

CORNER MONUMENT Set 1"x36" pipe & guard post

DATE MONUMENT PLACED AND WITNESSED 5-18-72

WITNESSES TO CORNER.....

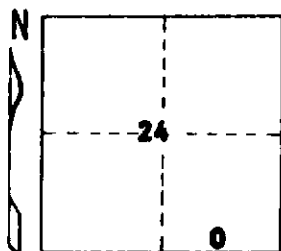

W. Cedar 14" N 20 E 61.78'

Cherry 10" N 85 W 25.50'


AND

Fence Post Iron 1.5 above grd. N 60 W 44.8'

CIRCLE CORNER REGISTERED

DESCRIPTION IN DETAIL AS TO HOW CORNER WAS LOCATED AND IDENTIFIED OR RESTORED.

Established corner per standard B.L.M. instructions.

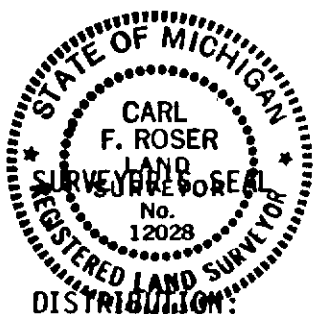

SIGNED Carl F. Roser DATE 5-25-72  
REGISTERED LAND SURVEYOR 12028

Forestry Division, Lansing