

STATE OF MICHIGAN
DEPARTMENT
OF
NATURAL RESOURCES

LAND CORNER RECORD


MASON COUNTY
T 18 N R 15 W

DESCRIPTION OF CORNER SE Corner Section 24

CORNER MONUMENT Forest Service Mon. 1.5' high & Cedar Post

DATE MONUMENT PLACED AND WITNESSED 5-18-72

WITNESSES TO CORNER..... Cedar 16" N 48 E 71.89'

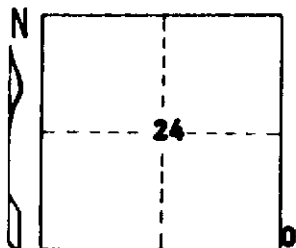

W. Pine 19" N 14 W 86.42'

NKly edge P.M. River Due W 44'


AND

C. line N-S Trail Road Due E 23'

CIRCLE CORNER REGISTERED

DESCRIPTION IN DETAIL AS TO HOW CORNER WAS LOCATED AND IDENTIFIED OR RESTORED.

Accepted U.S. Forest Service monument which has been used by other RLSs.

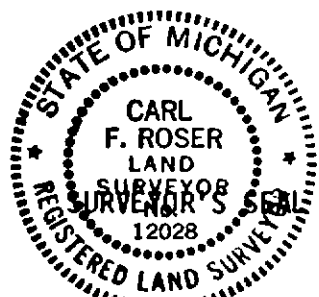

DISTRIBUTION:

Forestry Division, Lansing

SIGNED

Carl F. Roser

DATE

5-25-72

REGISTERED LAND SURVEYOR

12028