

STATE OF MICHIGAN
DEPARTMENT
OF
NATURAL RESOURCES

LAND CORNER RECORD


MASON COUNTY
T 18 N R 15 W

DESCRIPTION OF CORNER S 1/16 on E. line, Section 24

CORNER MONUMENT Found 1" Pipe flush

DATE MONUMENT PLACED AND WITNESSED 5-22-72

WITNESSES TO CORNER.....

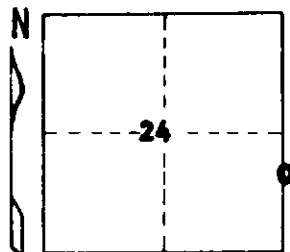

W. Pine 25" S 20 W 149.29'

Telephone Pole S 30 E 67.81'


AND

C. line N-S Trail Road Due E 9'

CIRCLE CORNER REGISTERED

DESCRIPTION IN DETAIL AS TO HOW CORNER WAS LOCATED AND IDENTIFIED OR RESTORED.

Recovered corner is equidistant and on line between section corner South and 1/4 corner North.

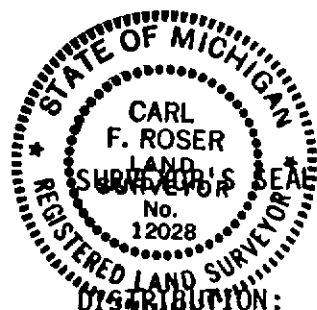

SIGNED

Carl F. Roser

DATE

5-30-72

REGISTERED LAND SURVEYOR

12028

Forestry Division, Lansing