

FEB 0 8 2000

LAND CORNER RECORDATION CERTIFICATE

Filing Requirement of Act 74, Mich. P.A. 1970

SECTION

For corners in MASON Located In: _____ Corner Code # _____
 (County)

1. Public Land Survey T 18N R 15W C-1
 T _____ R _____
 T _____ R _____
 T _____ R _____


2. Property Controlling S _____ T _____ R _____
 in Section S _____ T _____ R _____

3. Miscellaneous S _____ T _____ R _____

Property in Sec. S _____ T _____ R _____

4. Lot No. _____, Recorded Plat _____

5. Private Claims _____

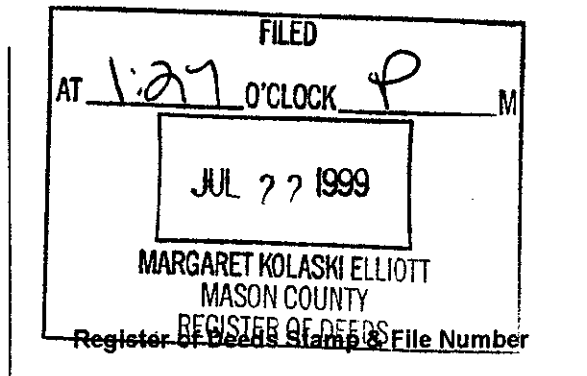

	A	B	C	D	E	F	G	H	I	J	K	L	M
1													
2	6	5	4	3	2	1							
3													
4	7	8	9	10	11	12							
5													
6	18	17	16	15	14	13							
7													
8	19	20	21	22	23	24							
9													
10	30	29	28	27	26	25							
11													
12	31	32	33	34	35	36							
13													

I, Kenneth L. Ross, in a field survey on June 5, 1999, do hereby certify that under requirements of P.A. 74, Michigan P.A. of 1970, the corner points mentioned in lines 1 and 2 above were in conformance with regulations and rules therefore as required in the current manual of survey instructions of the United States Department of the Interior, Bureau of Land Management or by a decree of a Court of Law and/or that the corner points mentioned in lines 3, 4 and 5 above were in conformance with the rules of the Michigan Board of Land Surveyors or by a Decree of a Court of Law, established, re-established, monumented, re-monumented, recovered, found as expressed below:

NOTE: Not more than 4 corners, all in the same town and range, may be recorded on this certificate.

A. Description of original monument and accessories and/or subsequent restoration:
 C-1, Corner Common to Sections 5 and 6, T.18N., R.15W.,
 Set by GLO, 2nd quarter, 1838.
 Mullet and Brookfield February, 1981, Act 132
 Nbdry, 55 links east of post K.L. Ross, "Set R/R. Spike"
 (1) Tamarack, 10", S 14°W, 13 links (8.58') Road intersection
 (2) Pine, 8", S 71°E, 6 links (3.96') (3) T.P. NE, 32.02'
 (4) Road Name Sign, SE, 34.4'
 Distance South to C-2, 2669.63'


J. Mitchell, Book 1, Page 68, December, 1983, Act 132
 May 1877 States Planted Stake K.L. Ross, No comment on corner
 No trees to take new bearings No Witnesses
 Distance South to C-2, 40.31 Chains (2660.46 feet) Distance East to D-1, 2604.74'

June, 1985, Act 132,
 K.L. Ross, "1/2" iron
 No Witnesses Given
 Distance West to A-1, 5241.31'

B. Description of corner evidence found and/or method applied in restoring or reestablishing corner:
 C-1, Corner Common to Sections 5 and 6, T.18N., R.15W.,

Found 1/2" X 18" Re-bar in the center-line of Decker and Larsen Roads. I found no other evidence to dispute the location of this corner. Witnesses (1), (2), and (4) have been destroyed. Witness (3) is standing, but is now a Guard post for a Telephone Box.

C. Description of monument for corner and accessories established to perpetuate locating the position of the corner:
 C-1, Corner Common to Sections 5 and 6, T.18N., R.15W.,
 I replaced the 1/2" X 18" re-bar in the exact location with a standard 3" Cast Iron Harrison Monument and is accepted as the best available evidence of the position of the original corner.
 (3) existing 60d spike, SE side, Tel Guard Post, N40°E, 31.38'
 (5) NBT, Set 60d spike in NW side of 8" Poplar, N67°E, 70.92'
 (6) NBT, Set 60d spike in SW side of Triple 4" Elm, S38°E, 58.90'
 (7) NBP, Center of Yield Sign and Street Sign Post, N34°W, 32.26'
 (8) Distance East to D-1, 2604.74' (Ross)
 (9) Distance West to A-1, 5241.31' (Ross)
 (10) Distance South to C-2, 2660.46' (Ross)

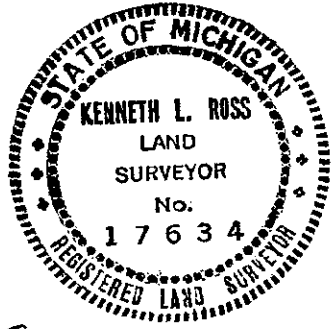

Signed by [Signature] Date 7-21-99
 Surveyor's Michigan License No. 17634

Peer Group Reviewed and Approved
 Date: 7-14-99
[Signature]
 Kenneth L. Ross
 Mason County Surveyor