


**SURVEY &
REMONUMENTATION**

OCT 30 1996

LAND CORNER RECORDATION CERTIFICATE
Filing Requirement of Act 74, Mich. P.A. 1970

For corners in **COMMISSION**


<u>MASON</u> County (County)	Located In:	Corner Code #
1. Public Land Survey	T <u>18N</u> R <u>15W</u>	<u>C-3</u>
	T <u> </u> R <u> </u>	<u> </u>
	T <u> </u> R <u> </u>	<u> </u>
2. Property Controlling in Section	S <u> </u> T <u> </u> R <u> </u>	<u> </u>
	S <u> </u> T <u> </u> R <u> </u>	<u> </u>
3. Miscellaneous Property in Sec.	S <u> </u> T <u> </u> R <u> </u>	<u> </u>
	S <u> </u> T <u> </u> R <u> </u>	<u> </u>

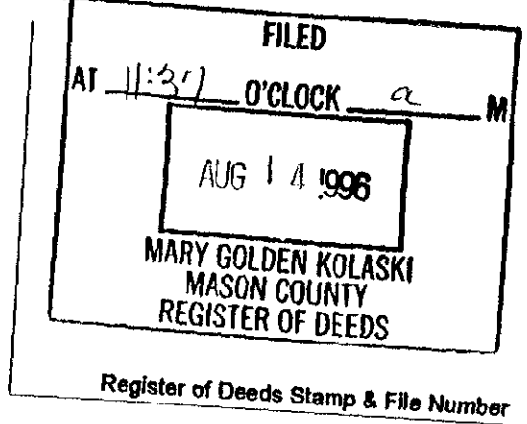

4. Lot No. _____, Recorded Plat _____
5. Private Claims _____

I, Sammy S. Barnett, in a field survey on July 12, 1996 do hereby state that under requirements of P.A. 74, Michigan P.A. of 1970, the corner points mentioned in lines 1 and 2 above were in conformance with regulations and rules therefore as required in the current manual of survey instructions of the United States Department of the Interior, Bureau of Land Management or by a decree of a Court of Law and/or that the corner points mentioned in lines 3, 4 and 5 above were in conformance with the rules of the Michigan Board of Land Surveyors or by a Decree of a Court of Law; established, re-established, monumented, recovered, found as expressed below:

NOTE: Not more than 2 corners, all in the same town and range, may be recorded on this certificate.

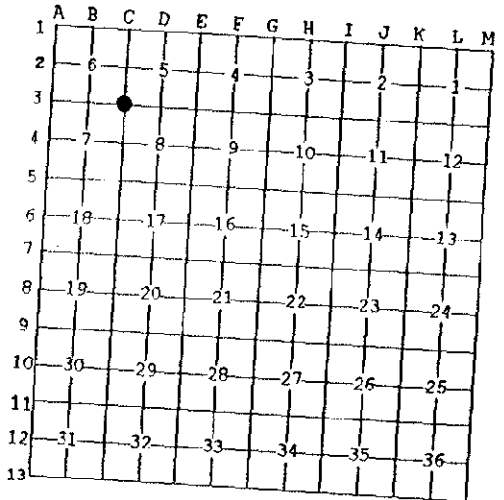

A. Description of original monument and accessories and/or subsequent restoration:

C-3 Section Corner for Sections 5, 6, 7 and 8, T18N, R15W.

1838, Sylvester Sibley, DS, G.L.O

- Set Wood Post
- #1 Beech 10" N42°W 81ks.(5.28')
- #2 Beech 10" S39°E 151ks.(9.90')

1897, R.O. Towns M.C.S.
Stone (cont.)

#3 NE corner of School House S30°-23'W 1311ks.(86.46')

1968, J. Borsfay, M.C. Road Comm.
Found big Stone & 3/4" Iron Rod

- #4 Power Pole SE 50.55'
- #5 Pear(twin) South 50.60'
- #6 NE corner School build. SE 93.0'

1973, J. Wilcox, #14102

- Found 1" x 2' Iron bar
- Raised w/ 1/2" iron bar
- #7 Apple 9" twin South 50.58'
- #8 P.P. S23°E 50.49'

B. Description of corner evidence found and/or method applied in restoring or reestablishing corner:

C-3 Section Corner for Sections 5, 6, 7 and 8, T18N, R15W.

On July 12, I found a 1/2" R.L.S. capped Re-Rod, can't read), inside an existing monument box, 3 feet South of the center-line of Hansen Road, I found no evidence to dispute this location for the corner.

Condition of recorded witnesses are;

- | | |
|-------------|--------------|
| #1 Gone | #5 Found |
| #2 Gone | #6 Same as 3 |
| #3 Gone | #7 Same as 5 |
| #4 Replaced | #8 Same as 4 |

C. Description of monument for corner and accessories established to perpetuate locating the position of the corner:

C-3 Section Corner for Sections 5, 6, 7 and 8, T18N, R15W.

I replaced the 1/2" Re-rod, in the exact location, with a Standard Mason County Monument, set inside the existing monument box, and is accepted as a careful and faithful reestablishment of the position of the original corner.

- (ext. BT #5) Apple 12" twin Due south 50.68'(added spike in West side of tree)
- (ext. BP) Power Pole S 54° W 48.14'(found spike in SE side of pole)
- Power Pole S 32° E 54.30'(60d spike in SW side of pole)
- Stop & Road Sign N 14° W 44.61' (east edge)

Signed by Sammy S. Barnett
Surveyor's Michigan License No. 16923

Date 8-12-96

Peer Group Reviewed
and Approved
Date: 8-12-96
Kenneth L. Ross
Mason County Surveyor

