


SURVEY & REMONUMENTATION

LAND CORNER RECORDATION CERTIFICATE Filing Requirement of Act 74, Mich. P.A. 1970

OCT 30 1996

For corners in

<u>MASON COMMISSION</u> <small>(County)</small>	Located In:	Corner Code #
1. Public Land Survey	T 18 N R 15 W	C-4
	T _____ R _____	_____
	T _____ R _____	_____
	T _____ R _____	_____
2. Property Controlling in Section	S _____ T _____ R _____	_____
	S _____ T _____ R _____	_____
3. Miscellaneous Property in Sec.	S _____ T _____ R _____	_____
	S _____ T _____ R _____	_____

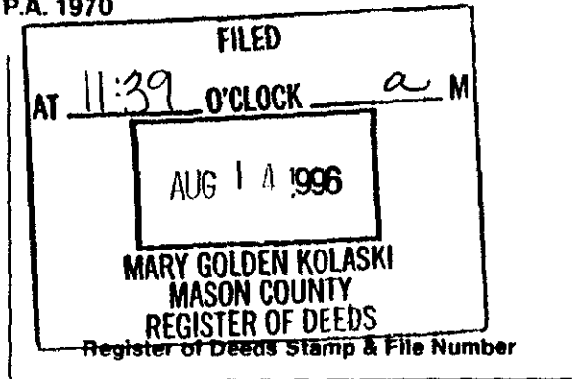

4. Lot No. _____, Recorded Plat _____
5. Private Claims _____

I, Sammy S. Barnett, in a field survey on July 12, 1996, do hereby certify that under requirements of P.A. 74, Michigan P.A. of 1970, the corner points mentioned in lines 1 and 2 above were in conformance with regulations and rules therefore as required in the current manual of survey instructions of the United States Department of the Interior, Bureau of Land Management or by a decree of a Court of Law and/or that the corner points mentioned in lines 3, 4 and 5 above were in conformance with the rules of the Michigan Board of Land Surveyors or by a Decree of a Court of Law; established, re-established, monumented, re-monumented, recovered, found as expressed below:

	A	B	C	D	E	F	G	H	I	J	K	L	M
2	6		5		4		3		2		1		
3													
4	7		8		9		10		11		12		
5													
6	18		17		16		15		14		13		
7													
8	19		20		21		22		23		24		
9													
10	30		29		28		27		26		25		
11													
12	31		32		33		34		35		36		
13													

NOTE: Not more than 4 corners, all in the same town and range, may be recorded on this certificate.

A. Description of original monument and accessories and/or subsequent restoration:

C-4 1/4 Corner for Sections 7 and 8, T18N, R15W.

1838, Sylvester Sibley, DS, G.L.O.
Set Wood Post
#1 Pine 16" S39°E 111ks.(7.26')
#2 Pine 12" N40°W 131ks.(8.58')

#3 White Oak 7" N25°E 56.25'
#4 Red Pine 3" S56°E 93.70'
#5 Red Pine 3" S43°W 67.65'
#6 Red Oak 6" N47°W 61.09'
#7 Pine Post 4" squ. West 1.8'

1973, Wilcox, #14102
Found Griffin Monument

1970, R.A. Griffin #13584

FD. G.L.O. witness #2 Stump

Set 5" x 5' conc. monument w/ brass cap Note; Griffin check Stream call to the North, distance fit well.

B. Description of corner evidence found and/or method applied in restoring or reestablishing corner:

C-4 1/4 Corner for Sections 7 and 8, T18N, R15W.

On July 12, I found a 5" squ. with a 3" Brass cap stamped for the corner, corner lies 20' North and 10 East of USFS trail roads. Note area as been cleared of some Pine stumps (original G.L.O.) found stump pile. I found no evidence to dispute this location for the corner. Monument is 1.5 feet above the surface of the ground.

Condition of recorded witnesses are;

- | | |
|----------------------------|----------------------------|
| #1 Gone | #6 Found in good condition |
| #2 Gone | #7 gone |
| #3 Found in good condition | |
| #4 Found in good condition | |
| #5 Found in good condition | |



C. Description of monument for corner and accessories established to perpetuate locating the position of the corner:

C-4 1/4 corner for Sections 7 and 8, T18N, R15W.

I accepted the 5" x 5' concrete Monument as a substantial marker for the corner. And is accepted as a careful and faithful perpetuation of the position of the original corner.

- (ext BT #3) White Oak 8" N 25° E 56.25'(dock spike in SE side of tree, scribed "BT")
 (ext BT #4) Red Pine 6" S 56° E 93.88'(dock spike in SW side of tree, scribed "BT")
 (ext. BT #5) Red Pine 8" S 43° W 67.77'(added 60d spike in SE side of tree, scribed "BT")
 (ext. BT #6) Red Oak 12" N 47° W 61.09'(dock spike in SW side of tree, scribed "BT")

Signed by Sammy S. Barnett

Date 8-17-96

Surveyor's Michigan License No. 16923

Peer Group Reviewed
and Approved
Date: 8-13-96
Kenneth I. Ross
Mason County Surveyor

FORM APPROVED BY MICHIGAN STATE BOARD OF LAND SURVEYORS, JAN. 28, 1971
REVISED MAY 14, 1975
REVISED JAN., 1983

LIBER

4 PAGE

2