

SURVEY &  
REMONUMENTATION

OCT 30 1996

COMMISSION

LAND CORNER RECORDATION CERTIFICATE  
Filing Requirement of Act 74, Mich. P.A. 1970

For corners in

MASON (County)	Located in:	Corner Code #
1. Public Land Survey	T 18 N R 15 W	C-5
	T _____ R _____	_____
	T _____ R _____	_____
	T _____ R _____	_____
2. Property Controlling in Section	S _____ T _____ R _____	_____
	S _____ T _____ R _____	_____
3. Miscellaneous Property in Sec.	S _____ T _____ R _____	_____
	S _____ T _____ R _____	_____

FILED  
AT 11:39 O'CLOCK a M  
AUG 14 1996  
MARY GOLDEN KOLASKI  
MASON COUNTY  
REGISTER OF DEEDS  
Register of Deeds Stamp & File Number

4. Lot No. \_\_\_\_\_, Recorded Plat \_\_\_\_\_  
5. Private Claims \_\_\_\_\_

I, Sammy S. Barnett, in a field survey on July 12, 1996, do hereby certify that under requirements of P.A. 74, Michigan P.A. of 1970, the corner points mentioned in lines 1 and 2 above were in conformance with regulations and rules therefore as required in the current manual of survey instructions of the United States Department of the Interior, Bureau of Land Management or by a decree of a Court of Law and/or that the corner points mentioned in lines 3, 4 and 5 above were in conformance with the rules of the Michigan Board of Land Surveyors or by a Decree of a Court of Law; established, re-established, monumented, re-monumented, recovered, found as expressed below:

NOTE: Not more than 4 corners, all in the same town and range, may be recorded on this certificate.

	A	B	C	D	E	F	G	H	I	J	K	L	M
2	6	5	4	3	2								
3													
4	7	8	9	10	11	12							
5													
6	18	17	16	15	14	13							
7													
8	19	20	21	22	23	24							
9													
10	30	29	28	27	26	25							
11													
12	31	32	33	34	35	36							
13													

A. Description of original monument and accessories and/or subsequent restoration:

C-5 Section Corner for Section 7, 8, 17 and 18, T18N, R15W.

1838, Sylvester sibley, DS, G.L.O. Set Wood Post #1 Pine 14" N53°E 71ks.(4.62') #2 Beech 8" S22°W 121ks.(7.92')	1973, J. Wilcox, #14102 Set 1/2" Re-rod @ double-proportion method #3 Oak 15" S40°W 23.84' #4 Oak 30" S18°E 19.32' #5 Oak 10" N32°E 24.72'	#6 W. Oak 8" N29°E 24.73' #7 B. Oak 25" S16°E 19.13' #8 W. Oak 16" S40°W 23.86' #9 Pine Post 4" x 7' West 0.70'
--	--	--

1978, R.A. Griffin,  
Found 1/2" re-rod

B. Description of corner evidence found and/or method applied in restoring or reestablishing corner:

C-5 Section Corner for Sections 7, 8, 17 and 18, T18N, R15W.

On July 12, I found a 1/2" re-rod next to a pine post 30 feet east of USFS trail road, I found no evidence to dispute this location for the corner.

Condition of recorded witnesses are;

- |                            |              |
|----------------------------|--------------|
| #1 Gone                    | #6 same as 5 |
| #2 Gone                    | #7 Same as 4 |
| #3 Found in good condition | #8 Same as 3 |
| #4 Found in good condition | #9 Gone      |
| #5 Found in good condition |              |

C. Description of monument for corner and accessories established to perpetuate locating the position of the corner:

C-5 Section Corner for Sections 7, 8, 17 and 18, T18N, R15W.


I replaced 1/2" Re-Rod, in the exact location with a standard Mason County Monument, flush with the ground, and is accepted as a careful and faithful reestablishment of the position of the original corner.

(ext. BT #3) Wht.Oak 20" S 40° W 24.15'(added 60d spike in SE side of tree)
(ext. BT #4) Blk.Oak 32" S 18° E 18.97'(added 60d spike in SW side of tree)
(ext. BT #5) Wht.Oak 14" N 32° E 24.63'(spike in SW side of tree)
Red Pine 7" N 37° W 34.00'(60d spike in SW side of tree)

Signed by Sammy S. Barnett  
Surveyor's Michigan License No. 16923

Date 8-12-96

Peer Group Reviewed  
and Approved  
Date: 8-13-96  
Kenneth L. Ross  
Mason County Surveyor

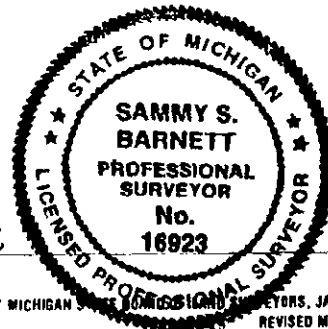

FORM APPROVED BY MICHIGAN BOARD OF PROFESSIONAL SURVEYORS, JAN. 28, 1971  
REVISED MAY 14, 1975  
REVISED JAN., 1993