

SURVEY & REMONUMENTATION


OCT 30 1996

COMMISSION

LAND CORNER RECORDATION CERTIFICATE
 Filing Requirement of Act 74, Mich. P.A. 1970

For corners in

MASON (County)	Located In:	Corner Code #
1. Public Land Survey	T 18 N. R 15 W	C-9
	T R	
	T R	
	T R	
2. Property Controlling in Section	S T R	
	S T R	
3. Miscellaneous Property in Sec.	S T R	
	S T R	
4. Lot No. _____, Recorded Plat _____		
5. Private Claims _____		

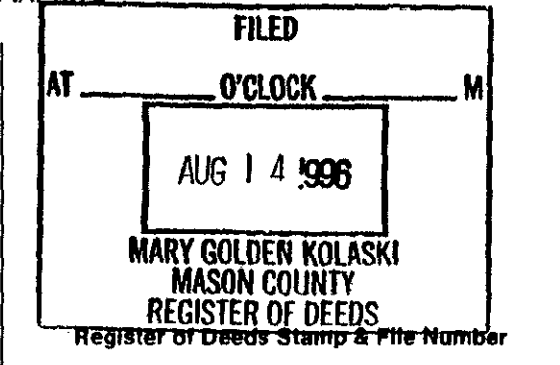

I, Sammy S. Barnett, in a field survey on July, 1996, do hereby certify that under requirements of P.A. 74, Michigan P.A. of 1970, the corner points mentioned in lines 1 and 2 above were in conformance with regulations and rules therefore as required in the current manual of survey instructions of the United States Department of the Interior, Bureau of Land Management or by a decree of a Court of Law and/or that the corner points mentioned in lines 3, 4 and 5 above were in conformance with the rules of the Michigan Board of Land Surveyors or by a Decree of a Court of Law; established, re-established, monumented, re-monumented, recovered, found as expressed below:

	A	B	C	D	E	F	G	H	I	J	K	L	M
2	6		5		4		3		2				
3													
4	7		8		9		10		11		12		
5													
6	18		17		16		15		14		13		
7													
8	19		20		21		22		23		24		
9													
10	30		29		28		27		26		25		
11													
12	31		32		33		34		35		36		
13													

NOTE: Not more than 4 corners, all in the same town and range, may be recorded on this certificate.

A. Description of original monument and accessories and/or subsequent restoration:

- C-9 Section Corner for Sections 19, 20, 29 and 30, T18N, R15W.
 - Sylvester Sibley, 1838, G.L.O. #4 Maple 12" S04°W 1331ks.(87.78')
 - 14" Pine for the Corner #5 Fence Corner Post South 11ks.(.66')
 - Charles Landon, pte 1940; P. Aman, 1940, USFS Found W. Pine Stump, set Wood Post in stump for G.L.O. Corner Ken Stephens, RLS, 1951 1 1/2" Iron Pipe set in fence corner post hole.
 - #1 White Pine 24" S63 1/2°W 1301ks.(85.80')
 - #2 Stone 6" N62 1/2°E 581ks.(38.28')
 - #3 Elm twin 6" & 8" N63°W 571ks.(37.62')
 - #6 Maple 15" S04°W 86.70'
 - #7 Power Pole S65°W 59.00'
 - #8 Maple 15" S87°W 90.50'
 - #9 CCC Marker N57°W 1.8'
 - Robert Griffin 13584, 1970 Found Conc. Plat Monument Replaced Monument w/ 5"x5' Conc. Monu. w/ 3" brass cap.
 - #10 Red Oak 6" N21°E 116.32 Cont. on Back

B. Description of corner evidence found and/or method applied in restoring or reestablishing corner:

- C-9 Section Corner for Sections 19, 20, 29 and 30, T18N, R15W.

On July 11, I found a Griffin Monument(5" squ. x 5' long conc. monument with 3" brass disk, also found a conc. plat monument 0.70' south of Griffin monument, buried under-ground, found no evidence to dispute this location for the corner.

Condition of recorded witnesses are;


 - #1 Found remains of old pine stump
 - #2 Gone
 - #3 Gone
 - #4 found in good condition
 - #5 Gone
 - #6 Same as 4
 - #7 Found in good condition
 - #8 Found in good condition
 - #9 Gone
 - #10 Found in good condition tree-tag)
 - #11 Same as 4
 - #12 Same as 7
 - #13 Found in good condition
 - #14 Found in good condition
 - #15 Same as 13
 - #16 Same as 4
 - #17 Same as 10

C. Description of monument for corner and accessories established to perpetuate locating the position of the corner:

- C-9 Section Corner for Sections 19, 20, 29 and 30, T18N, R15W.

I accepted 5" squ. x 5 foot long conc. monument with 3" brass disk, as a substantial marker for this corner, and is accepted as a careful and faithful perpetuation of the position of the original corner,

 - (ext. BI #4) Maple 26" S 04° W 87.13'(60d spike in East side of tree)
 - (ext. BI #7) Power Pole S 65° W 58.94'(16p w/ shiner in SE side of pole)'
 - (ext. BI #13) Red Pine 10" N 21° W 178.87'(dock spike in SW side of tree w/ tree-tag)
 - Black Oak 17" S 80° E 62.03'(60d spike in North side of tree)

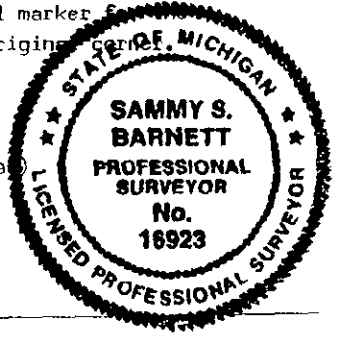

Signed by Sammy S. Barnett Date 8-17-96
 Surveyor's Michigan License No. 16923
 Peer Group Reviewed and Approved
 Done 8-17-96
Kenneth L. Ross
 Mason County Surveyor

C-9 Section Corner for Section 19, 20, 29 and 30, T18N, R15W.

Griffin 1940 (cont.)

#11 Maple 19" S04°W 87.13'
#12 Power Pole S64°W 58.94'
#13 Red Pine 5" N22°W 178.97'
#14 Pine Post 4"x7' Noeth 1.115'
all trees scribed "BT"

Carl Roser, RLS # 12028, 1978

Found USFS Conc. Monument w/ brass cap
Corner fits Charles Landon witnesses by 2 ft.
#15 Red Pine 7" N20°W 178.87'
#16 Maple 22" N05°W 87.13'
#17 Red Oak 7" N20°E 116.32'

Ken Ross, RLS # 17634, 1993

Use Conc. USFUS monument in survey # 93282S

SURVEY &
REMONUMENTATION

OCT 30 1996

COMMISSION