

SURVEY & REMONUMENTATION

OCT 30 1996

COMMISSION LAND CORNER RECORDATION CERTIFICATE
Filing Requirement of Act 74, Mich. P.A. 1970

For corners in

MASON (County)	Located In:	Corner Code #
1. Public Land Survey	T 18 N R 15 W	C-10
	T _____ R _____	_____
	T _____ R _____	_____
	T _____ R _____	_____
2. Property Controlling in Section	S _____ T _____ R _____	_____
	S _____ T _____ R _____	_____
3. Miscellaneous Property in Sec.	S _____ T _____ R _____	_____
	S _____ T _____ R _____	_____

Register of Deeds Stamp & File Number

4. Lot No. _____, Recorded Plat _____
 5. Private Claims _____

I, Sammy S. Barnett, in a field survey on July 11, 1996, do hereby certify that under requirements of P.A. 74, Michigan P.A. of 1970, the corner points mentioned in lines 1 and 2 above were in conformance with regulations and rules therefore as required in the current manual of survey instructions of the United States Department of the Interior, Bureau of Land Management or by a decree of a Court of Law and/or that the corner points mentioned in lines 3, 4 and 5 above were in conformance with the rules of the Michigan Board of Land Surveyors or by a Decree of a Court of Law; established, re-established, monumented, re-monumented, recovered, found as expressed below:

	A	B	C	D	E	F	G	H	I	J	K	L	M
2	6	5	4	3	2	1							
3													
4	7	8	9	10	11	12							
5													
6	18	17	16	15	14	13							
7													
8	19	20	21	22	23	24							
9													
10	30	29	28	27	26	25							
11													
12	31	32	33	34	35	36							
13													

NOTE: Not more than 4 corners, all in the same town and range, may be recorded on this certificate.

A. Description of original monument and accessories and/or subsequent restoration:

C-10 1/4 Corner for Sections 29 and 30, T18N, R15W.

Sylvester Sibley, 1838, G.L.O.
 Set Wood Post
 #1 Pine 14" N80°W 191ks.(12.54')

Ken Ross, RLS #17634, 1993
 Found 1/2" capped Re-Rod by Clint Cole
 #5 W. Oak 14" S04°W 47.50'
 #6 Maple 10" N68°W 9.78'
 #7 White Oak S26°W 29.61' (10" W. O.)
 #8 3"x 3' plastic pipe filled w/ conc. S45°W 0.40'

Clint Cole, RLS #17615, 1975
 Set 1/2" Re-Rod w/ RLS cap
 #2 White Oak 10" S28°W 29.54'
 #3 Maple 7" N72°W 331.88'
 #4 White Oak 14" S35°E 58.07'

B. Description of corner evidence found and/or method applied in restoring or reestablishing corner:

C-10 1/4 Corner for Sections 29 and 30, T18N, R15W.

On July 11, I found a 1/2" Re-rod with RLS cap #17615 (Clint Cole), I found no evidence to dispute this location for the corner.

Condition of recorded witnesses are;

- #1 Gone
- #2 Gone
- #3 Found in good condition
- #4 Found in good condition
- #5 Found in good condition
- #6 Found in good condition
- #7 Same as 2
- #8 Found in good condition

C. Description of monument for corner and accessories established to perpetuate locating the position of the corner:

C-10 1/4 Corner for Sections 29 and 30, T18N, R15W.

I replaced 1/2" Re-rod, in the exact location, with a standard Mason County Monument, set flush with the ground, and is accepted as a careful and faithful reestablishment of the position of the original corner.


- (ext. BT #3) Maple 10" N 72° W 31.88' (60d spike in SW side of tree)
- (ext. BT #4) White Oak 16" S 35° E 58.07' (60d spike in SW side of tree)
- (ext. BT #5) White Oak 16" S 04° W 47.50' (60d spike in East side of tree)
- (ext. BT #6) Maple 12" N 68° W 9.78' (60d spike in NE side of tree)

Signed by Sammy S. Barnett

Date 8-17-96

Surveyor's Michigan License No. 16923

Peer Group Reviewed and Approved
 Date: 8-13-96
Kenneth L. Ross
 Mason County Surveyor

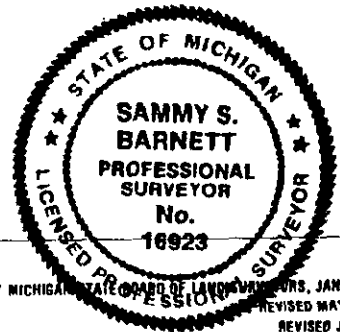

FORM APPROVED BY MICHIGAN STATE BOARD OF LAND SURVEYORS, JAN. 28, 1971
 REVISIONS: REVISION MAY 14, 1975
 REVISED JAN., 1983

LIBER

4 PAGE

7