

# SURVEY & REMONUMENTATION


OCT 30 1996

## LAND CORNER RECORDATION CERTIFICATE Filing Requirement of Act 74, Mich. P.A. 1970

For corners in

MASON (County) **COMMISSION** Located In: Corner Code #7

1. Public Land Survey	T 18 N R 15 W	C-11	
	T _____ R _____	_____	_____
	T _____ R _____	_____	_____
	T _____ R _____	_____	_____
2. Property Controlling in Section	S _____ T _____ R _____	_____	_____
	S _____ T _____ R _____	_____	_____
3. Miscellaneous Property in Sec.	S _____ T _____ R _____	_____	_____
	S _____ T _____ R _____	_____	_____

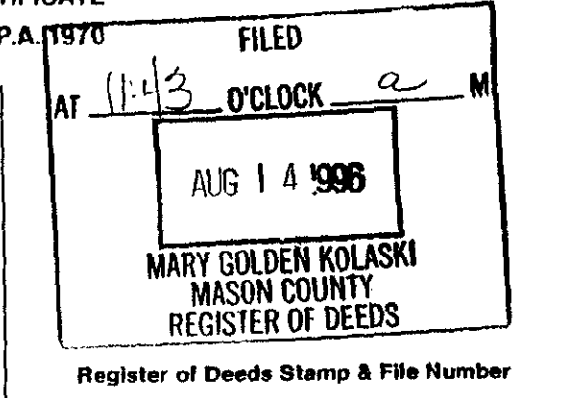

4. Lot No. \_\_\_\_\_, Recorded Plat \_\_\_\_\_  
5. Private Claims \_\_\_\_\_

I, Sammy S. Barnett, in a field survey on July 11, 1996, do hereby certify that under requirements of P.A. 74, Michigan P.A. of 1970, the corner points mentioned in lines 1 and 2 above were in conformance with regulations and rules therefore as required in the current manual of survey instructions of the United States Department of the Interior, Bureau of Land Management or by a decree of a Court of Law and/or that the corner points mentioned in lines 3, 4 and 5 above were in conformance with the rules of the Michigan Board of Land Surveyors or by a Decree of a Court of Law; established, re-established, monumented, re-monumented, recovered, found as expressed below:

**NOTE: Not more than 4 corners, all in the same town and range, may be recorded on this certificate.**

A	B	C	D	E	F	G	H	I	J	K	L	M
2	6	5	4	3	2							
3												
4	7	8	9	10	11	12						
5												
6	16	17	18	15	14	13						
7												
8	19	20	21	22	23	24						
9												
10	30	29	28	27	26	25						
11												
12	31	32	33	34	35	36						
13												

**A. Description of original monument and accessories and/or subsequent restoration:**

C-11 Section Corner for Sections 29, 30, 31 and 32, T18N, R15W.

<u>Sylvester Sibley, 1838, G.L.O.</u> Set Wood Post #1 Pine 16" N38°E 271ks.(17.82') #2 Pine 14" S25°W 201ks.(13.20')	#4 White Oak 7" N59½°E 1021ks.(67.32') <u>Robert Griffin, RLS#13584, 1970</u> Found G.L.O. witnesses and Landon's witnesses, then located rotted Wood Stake, replaced Stake w/ a 5" squ. x 5' Conc. Monument w/ 3" brass cap, marked accordingly. #5 Black Oak 5" N25°E 40.24' (10" D.S. SE side of tree) #6 White Oak 5" S55°E 69.95' (10" D.S. NE side of tree) #7 White Oak 6" S75°W 63.71' (10" D.S. North side of tree)	#8 Black Oak 5" N15°W 60.63' #9 Pine Post 4" North 2.00'
--	---	---

#3 White Oak 10" N69°W 381ks.(25.08')  
Charles Landon, no date  
Monument not given

**B. Description of corner evidence found and/or method applied in restoring or reestablishing corner:**

C-11 Section Corner for Sections 29, 30, 31 and 32, T18N, R15W.

On July 11, I found Griffin Monument (5" squ. x 5' Conc. Monu.), also found fence line to the East. I found no evidence to dispute this location for the corner.

Condition of recorded witnesses are;

#1 Found remains of old pine stump	#6 Found in good condition - tree tag
#2 Found remains of old pine stump	#7 Found in good condition - tree tag
#3 Found in good condition	#8 Found in good condition
#4 Found in good condition	#9 Found in good condition
#5 Found in good condition - tree tag	


**C. Description of monument for corner and accessories established to perpetuate locating the position of the corner:**

C-11 Section Corner for Section 29, 30, 31 and 32, T18N, R15W.

I accepted 5" squ. x 5' long, conc. monument with 3" brass disk as a substantial marker for the corner, and is accepted as a careful and faithful perpetuation of the position of the original corner.

(ext. BT #5) Black Oak 10"	N 25° E	40.24'	(10" dock spike in SE side of tree)
(ext. BT #6) White Oak 9"	S 55° E	69.95'	(10" dock spike in NE side of tree)
(ext. BT #7) White Oak 10"	S 75° W	63.71'	(10" dock spike in North side of tree)
(ext. BT #8) Black Oak 9"	N 15° W	60.58'	(10" dock spike in SW side of tree)

Signed by Sammy S. Barnett Date 8-12-96  
Surveyor's Michigan License No. 16923  
Peer Group Reviewed and Approved  
Date: 8-12-96  
Sammy S. Barnett  
Mason County Surveyor

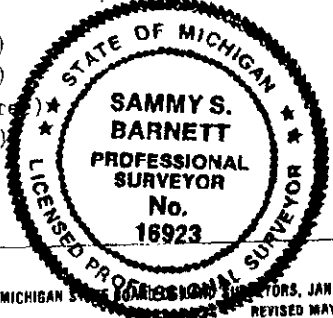

FORM APPROVED BY MICHIGAN SURVEYORS, JAN. 20, 1971  
REVISED MAY 14, 1975  
REVISED JAN., 1983