

FEB 08 2000

LAND CORNER RECORDATION CERTIFICATE
 Filing Requirement of Act 74, Mich. P.A. 1970

SECTION

For corners in MASON Located In: _____ Corner Code # _____
 (County)

1. Public Land Survey T 18N R 15W _____ D-1
 T _____ R _____
 T _____ R _____
 T _____ R _____


2. Property Controlling S _____ T _____ R _____
 in Section S _____ T _____ R _____

3. Miscellaneous S _____ T _____ R _____

Property in Sec. S _____ T _____ R _____

4. Lot No. _____, Recorded Plat _____

5. Private Claims _____

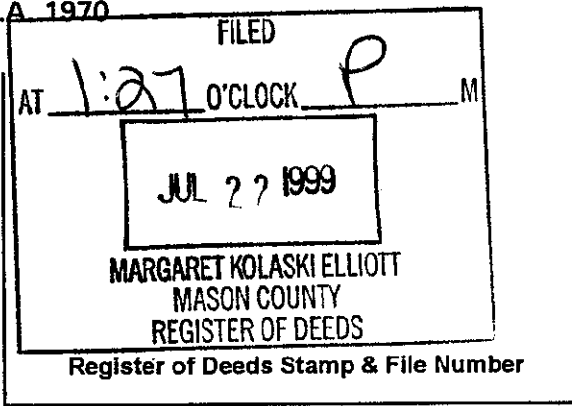

	A	B	C	D	E	F	G	H	I	J	K	L	M
1													
2	6			5			4			3		2	1
3													
4	7			8			9			10		11	12
5													
6	18			17			16			15		14	13
7													
8	19			20			21			22		23	24
9													
10	30			29			28			27		26	25
11													
12	31			32			33			34		35	36
13													

I, Kenneth L. Ross, in a field survey on June 5, 1999, do hereby certify that under requirements of P.A. 74, Michigan P.A. of 1970, the corner points mentioned in lines 1 and 2 above were in conformance with regulations and rules therefore as required in the current manual of survey instructions of the United States Department of the Interior, Bureau of Land Management or by a decree of a Court of Law and/or that the corner points mentioned in lines 3, 4 and 5 above were in conformance with the rules of the Michigan Board of Land Surveyors or by a Decree of a Court of Law, established, re-established, monumented, re-monumented, recovered, found as expressed below:

NOTE: Not more than 4 corners, all in the same town and range, may be recorded on this certificate.

A. Description of original monument and accessories and/or subsequent restoration:
 D-1 N ¼ Corner Section 5, T.18N., R.15W.,
 GLO did not set this corner.

December, 1983, Act 132, K.L. Ross,
 "Set ½" Re-bar, No Witnesses Given
 Distance East to E-1, 2639.82'
 Distance West to C-1, 2639.82'

July, 1991, LCRC, Liber 3, page 36
 Theodore H. Weinert, 19846
 Corner Recorded in error
 Corner is actually D-13 of T.19N., R.15W.,
 Not D-1, T.18N., R.15W., as stated.

B. Description of corner evidence found and/or method applied in restoring or reestablishing corner:
 D-1 N ¼ Corner Section 5, T.18N., R.15W.,


I found a ½" X 18" re-bar as described by K.L. Ross, above. I found no other evidence to dispute the location of this Corner.

C. Description of monument for corner and accessories established to perpetuate locating the position of the corner:
 D-1 N ¼ Corner Section 5, T.18N., R.15W.,

I removed the ½" X 18" iron re-rod and replaced it in the exact location with a Standard 3" Cast Iron Harrison Mason County Monument and placed a monument box. This position not established by original Government surveyors. This Monument is accepted as the best available evidence of the position of the corner.

- (1) Set 60d spike SE side, 18" Elm, N25°E, 35.42'
- (2) Set 60d spike West side of P.P. S11°W, 39.88'
- (4) Center of East Post of County Road Commission double arrow sign, S58°W, 44.73'
- (5) ½" iron re-rod, South 33.00'
- (6) Center of Steel Fence Post, S43°E, 48.26'
- (7) Corner D-13, T.19N., R.15W., West, 35.04'

Note this corner located 3 foot North of the center-line of Decker Road and 35 foot East of Morris Road to the North.

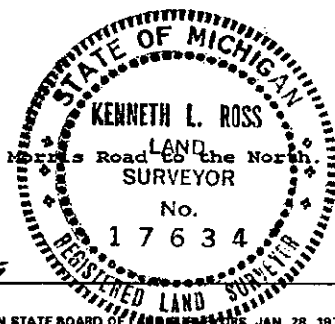

Signed by [Signature] Date 7-21-99
 Surveyor's Michigan License No. 17634

Peer Group Reviewed and Approved
 Date: 7-14-99
[Signature]
 Kenneth L. Ross

APPROVED BY MICHIGAN STATE BOARD OF LAND SURVEYORS, JAN. 28, 1971
 REVISED MAY 14, 1971
 REVISED JAN., 1981
 ADAPTED FOR WORD PROCESSING MARCH, 1991