


SURVEY & REMONUMENTATION

OCT 30 1996

LAND CORNER RECORDATION CERTIFICATE Filing Requirement of Act 74, Mich. P.A. 1970

For corners in **COMMISSION**

MASON	Located In:	Corner Code #	
(County)			
1. Public Land Survey	T 18N R 15W	D-3	
	T ___ R ___	_____	_____
	T ___ R ___	_____	_____
	T ___ R ___	_____	_____
2. Property Controlling In Section	S ___ T ___ R ___	_____	_____
	S ___ T ___ R ___	_____	_____
3. Miscellaneous Property in Sec.	S ___ T ___ R ___	_____	_____
	S ___ T ___ R ___	_____	_____

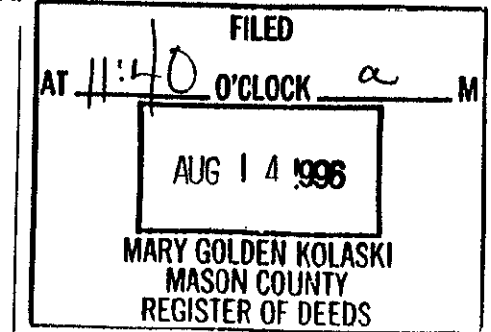

Register of Deeds Stamp & File Number

4. Lot No. _____, Recorded Plat _____
5. Private Claims _____

I, Sammy S. Barnett, in a field survey on July 12, 1996 do hereby state that under requirements of P.A. 74, Michigan P.A. of 1970, the corner points mentioned in lines 1 and 2 above were in conformance with regulations and rules therefore as required in the current manual of survey instructions of the United States Department of the Interior, Bureau of Land Management or by a decree of a Court of Law and/or that the corner points mentioned in lines 3, 4 and 5 above were in conformance with the rules of the Michigan Board of Land Surveyors or by a Decree of a Court of Law; established, re-established, monumented, recovered, found as expressed below:

NOTE: Not more than 2 corners, all in the same town and range, may be recorded on this certificate.

	A	B	C	D	E	F	G	H	I	J	K	L	M
1													
2	6			5		4		3		2		1	
3				●									
4	7			8		9		10		11		12	
5													
6	19			17		16		15		14		13	
7													
8	19			20		21		22		23		24	
9													
10	30			29		28		27		26		25	
11													
12	31			32		33		34		35		36	
13													

A. Description of original monument and accessories and/or subsequent restoration:

D-3 1/4 Corner for Sections 5 and 8, T18N, R15W.

- | | | |
|--|--|-------------------------|
| <u>Sylvester Sibley, D.S. 1838, G.L.O.</u> | #3 Power Pole NW 97.5' | #8 Pipe 2" North 29.80' |
| Set Wood Post | #4 Pipe 2" North 29.8' | |
| #1 Hemlock 16" S23°W 141ks.(9.24') | #5 Stump 15" South 51.7' | |
| #2 Beech 10" N26°E 91ks.(5.94') | | |
| <u>Mason County Road Comm., 1968</u> | <u>Jerry Wilcox, R.L.S. #14102, 1973</u> | |
| 2" Iron Pipe (cont.) | Set 1/2" Iron from old witnesses | |
| | #6 apple 20" N45°W 50.48' | |
| | #7 Stump South 51.70' | |

B. Description of corner evidence found and/or method applied in restoring or reestablishing corner:

D-3 1/4 corner for Sections 5 and 8, T18N, R15W.

On July 12, I found a 1/2" Re-Rod inside a buried monument box (under 0.3' of asphalt), 4 feet North of the Center-line of Hansen Road, I found no evidence to dispute this location for the corner.

Condition of recorded witnesses are;

- | | | | |
|---------|-------------|----------------------------|--------------|
| #1 Gone | #3 Replaced | #5 Found Stump | #7 Same as 5 |
| #2 Gone | #4 Gone | #6 Found in fair condition | |

C. Description of monument for corner and accessories established to perpetuate locating the position of the corner:


D-3 1/4 Corner for Sections 5 and 8, T18N, R15W.

I raised existing monument box and placed a Standard Mason County Monument, in the exact location of the existing 1/2" Re-Rod, and is accepted as a faithful and careful reestablishment of the position of the original corner.

- (ext. BT #6 Apple 22" N 45° W 50.36'(16p nail in NE side of tree)
- (ext. BT) Apple 20" N 22° W 40.65'(16p nail in East side of tree)
- Maple 13" south 55.13'(spike in East of tree)
- RLS Capped Iron North 33.90'

Signed by Sammy S. Barnett
Surveyor's Michigan License No. 16923

Date 8-12-96

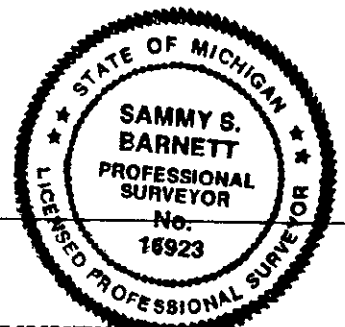

Peer Group Reviewed and Approved
Date: 8-13-96
Elizabeth L. Ross
Mason County Surveyor

FORM APPROVED BY MICHIGAN STATE BOARD OF PROFESSIONAL SURVEYORS, JAN. 28, 1971

REVISED MAY 14, 1975
REVISED JAN., 1983
REVISED OCT., 1995