


SURVEY & REMONUMENTATION

OCT 30 1996

LAND CORNER RECORDATION CERTIFICATE Filing Requirement of Act 74, Mich. P.A. 1970

For corners in MASON **COMMISSION**

MASON _____ (County)	Located In:	Corner Code #
1. Public Land Survey	T <u>18</u> R <u>15</u> W T _____ R _____ T _____ R _____ T _____ R _____	<u>D-5</u> _____ _____ _____
2. Property Controlling in Section	S _____ T _____ R _____ S _____ T _____ R _____	_____ _____ _____
3. Miscellaneous Property in Sec.	S _____ T _____ R _____ S _____ T _____ R _____	_____ _____ _____

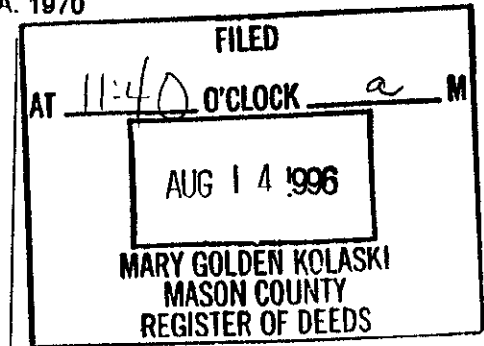

Register of Deeds Stamp & File Number

4. Lot No. _____, Recorded Plat _____
 5. Private Claims _____

I, Sammy S. Barnett, in a field survey on July 12 19 26 do hereby state that under requirements of P.A. 74, Michigan P.A. of 1970, the corner points mentioned in lines 1 and 2 above were in conformance with regulations and rules therefore as required in the current manual of survey instructions of the United States Department of the Interior, Bureau of Land Management or by a decree of a Court of Law and/or that the corner points mentioned in lines 3, 4 and 5 above were in conformance with the rules of the Michigan Board of Land Surveyors or by a Decree of a Court of Law; established, re-established, monumented, recovered, found as expressed below:

NOTE: Not more than 2 corners, all in the same town and range, may be recorded on this certificate.

A	B	C	D	E	F	G	H	I	J	K	L	M
1												
2	6		5		4		3		2		1	
3												
4	7		8		9		10		11		12	
5												
6	18		17		16		15		14		13	
7												
8	19		20		21		22		23		24	
9												
10	30		29		28		27		26		25	
11												
12	31		32		33		34		35		36	
13												

A. Description of original monument and accessories and/or subsequent restoration:

D-5 1/4 corner for Sections 8 and 17, T18N, R15W.

1838, Sylvester Sibley, DS, G.L.O.

Set Wood post

#1 Beech 12" N41°W 211ks.(13.86')

#2 Maple 8" S40°E 201ks.(13.2')

1973, J. Wilcox, #14102

Set 1/2" re-rod @ single proportional method

#3 Red Pine 3" N05°E 21.91'

#4 Red Pine 5" S87°E 4.86'

#5 Red pine 6" S88°W 6.10'

1978, R.A. Griffin, #13854

Found 1/2" Re-rod

#6 Red Pine 3" N01°W 21.86'

#7 Red Pine 5" S86°E 4.89'

#8 Red Pine 5" S81° W 6.10'

B. Description of corner evidence found and/or method applied in restoring or reestablishing corner:

D-5 1/4 corner for Sections 8 and 17, T18N, R15W.

On July 12, I found a 1/2" Re-rod, 35 feet South of the center-line of USFS trail road, that fits existing witnesses. I found no evidence to dispute this location for the corner.

Condition of recorded witnesses are;

#1 Gone

#2 Gone

#3 Found stump

#4 Found in good condition with tree tag

#5 Found in good condition with tree tag

#6 Same as 3

#7 Same as 4

#8 Same as 5

C. Description of monument for corner and accessories established to perpetuate locating the position of the corner:

D-5 1/4 corner for Sections 8 and 17, T18N, R15W.

I replaced 1/2" Re-rod, in the exact location, with a Standard Mason County Monument flush with the surface of the ground, and is accepted as a careful and faithful reestablishment of the position of the original corner.

(ext. BT #4) Red Pine 10" S 86° E 4.89'(60d spike in NW side of tree)

(ext. BT #5) Red Pine 8" S 81° W 6.10'(60d spike in NW side of tree)

(ext. BT) White Oak 28" N 30° E 54.72'(60d spike in SE side of tree)

Red Pine 16" N 42° W 29.77'(60d spike in NE side of tree)

Signed by Sammy S. Barnett

Surveyor's Michigan License No. 16923

Date 8-17-96



Peer Group Reviewed and Approved

Date: 8-13-96

Kenneth L. Ross
Mason County Surveyor

FORM APPROVED BY MICHIGAN STATE BOARD OF PROFESSIONAL SURVEYORS, JAN. 28, 1971

REVISED MAY 14, 1975

REVISED JAN., 1983

REVISED OCT., 1985