

LAND CORNER RECORDATION CERTIFICATE

Filing Requirement of Act 74, Mich. P.A.

For corners in MASON (County) Located In: Corner Code #

1. Public Land Survey T 18N R 15W E-1


2. Property Controlling in Section S T R

3. Miscellaneous S T R

Property in Sec. S T R

4. Lot No. _____, Recorded Plat _____

5. Private Claims _____

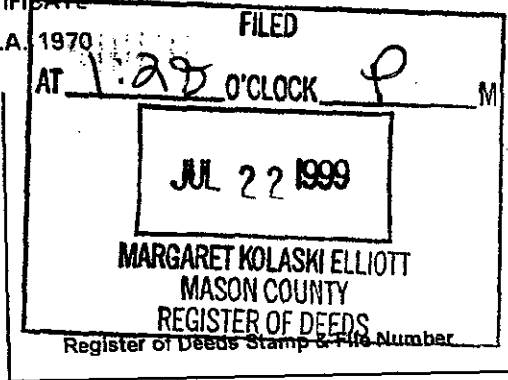

	A	B	C	D	E	F	G	H	I	J	K	L	M
1													
2	6	5	4	3	2	1							
3													
4	7	8	9	10	11	12							
5													
6	18	17	16	15	14	13							
7													
8	19	20	21	22	23	24							
9													
10	30	29	28	27	26	25							
11													
12	31	32	33	34	35	36							
13													

I, Kenneth L. Ross, in a field survey on June 5, 1999, do hereby certify that under requirements of P.A. 74, Michigan P.A. of 1970, the corner points mentioned in lines 1 and 2 above were in conformance with regulations and rules therefore as required in the current manual of survey instructions of the United States Department of the Interior, Bureau of Land Management or by a decree of a Court of Law and/or that the corner points mentioned in lines 3, 4 and 5 above were in conformance with the rules of the Michigan Board of Land Surveyors or by a Decree of a Court of Law; established, re-established, monumented, re-monumented, recovered, found as expressed below:

NOTE: Not more than 4 corners, all in the same town and range, may be recorded on this certificate.

A. Description of original monument and accessories and/or subsequent restoration:

E-1, Corner Common to Sections 4 and 5, T.18N., R.15W.,
GLO, 2nd quarter, 1838
Mullet and Brookfield
Tamarack, 8", for cor.
Secs. 4 & 5, No Witnesses
Distance South to E-2, 2638.68'
(39.98 chains)

November, 1980, Act 132
K.L. Ross, "Fd. Iron"
No Witnesses Given
Distance South to E-2, 2505.62'

June, 1983, Act 132
K.L. Ross, "ex. 4" iron"
No Witnesses Given
Distance South to E-2, 2505.62'

December, 1983, Act 132
K.L. Ross, "ex. 4" iron"
No Witnesses Given
Distance West to D-1, 2639.82'

May, 1984, Act 132, K.L. Ross
No Comment on Corner, No Witnesses
Distance South to E-2, 2504.44'

July, 1984, Act 132, K.L. Ross
Liber 318, Page 433, "Fd. Iron re-bar"
No Witnesses Given.
Distance South to E-2, 2505.62'

July, 1991, LCRC, Liber 3, page 36
Theodore H. Weinert, 19846
"Fd. 4" re-bar, set Monument Box"
(1) Fireside Sign Post, N45°W, 50.4'
(2) P.P. S45°W, 54.00'
(3) Stop sign post, S35°E, 28'

B. Description of corner evidence found and/or method applied in restoring or reestablishing corner:

E-1, Corner Common to Sections 4 and 5, T.18N., R.15W.,
I found a 1/2" X 18" re-bar inside a Monument Box. I found no other evidence to dispute the location of this corner.
Witness (3) has been destroyed. Witnesses (1) and (2) are standing and in good condition.

C. Description of monument for corner and accessories established to perpetuate locating the position of the corner:

E-1, Corner Common to Sections 4 and 5, T.18N., R.15W.,
I removed the 1/2" X 18" Rebar and placed in its exact location a 5/8" X 24" re-bar with a 3" standard aluminum cap stamped Mason County Monument inside the Monument Box. 7 foot East of the center-line of Benson Road and on the center-line of Decker Road and accepted this as the best available evidence of the re-establishment of the position of the original corner.

(1) Center of Fireside Sign Post N45°W., 50.40'
(2) Existing 60d spike SE side of P.P. S49°W, 53.88'
(4) Set 60d spike SW side of Guy Pole, S35°E, 46.89'
(5) Center of the North 2" dia. Guard Post to A Pay Telephone, N35°W, 61.55'
(6) Center of a 3" Steel Post approximately 7' tall, N25°W, 76.37'
(7) Set 60d Spike, NW side of 6" White Pine, N28°E, 66.18'

Signed by [Signature] Date July 21, 1999

Surveyor's Michigan License No. 17634

FORM APPROVED BY MICHIGAN STATE BOARD OF LAND SURVEYORS, JAN. 28, 1971
REVISED MAY 14, 1976
REVISED JAN., 1983
ADAPTED FOR WORD PROCESSING MARCH, 1983

SURVEY &
REMONUMENTATION

FEB 08 2000

SECTION

Peer Group Reviewed
and Approved
Date: 7-14-99
[Signature]
Kenneth L. Ross
Mason County Surveyor



LIBER

4 PAGE 272