


SURVEY & REMONUMENTATION

OCT 30 1996

LAND CORNER RECORDATION CERTIFICATE
Filing Requirement of Act 74, Mich. P.A. 1976

For corners in **COMMISSION**

MASDN _____ (County)	Located In:	Corner Code #
1. Public Land Survey	T 18 N R 15 W	E-9
	T _____ R _____	_____
	T _____ R _____	_____
	T _____ R _____	_____
2. Property Controlling in Section	S _____ T _____ R _____	_____
	S _____ T _____ R _____	_____
3. Miscellaneous Property in Sec.	S _____ T _____ R _____	_____
	S _____ T _____ R _____	_____
4. Lot No. _____, Recorded Plat _____		
5. Private Claims _____		

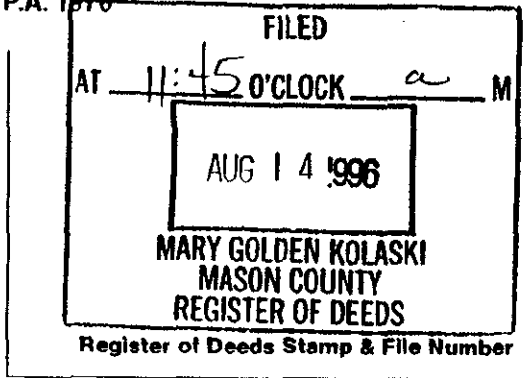

A	B	C	D	E	F	G	H	I	J	K	L	M
2	6	5	4	3	2							
3												
4	7	8	9	10	11	12						
5												
6	18	17	16	15	14	13						
7												
8	19	20	21	22	23	24						
9												
10	30	29	28	27	26	25						
11												
12	31	32	33	34	35	36						
13												

I, Sammy S. Barnett, in a field survey on July 16, 1996, do hereby certify that under requirements of P.A. 74, Michigan P.A. of 1970, the corner points mentioned in lines 1 and 2 above were in conformance with regulations and rules therefore as required in the current manual of survey instructions of the United States Department of the Interior, Bureau of Land Management or by a decree of a Court of Law and/or that the corner points mentioned in lines 3, 4 and 5 above were in conformance with the rules of the Michigan Board of Land Surveyors or by a Decree of a Court of Law; established, re-established, monumented, re-monumented, recovered, found as expressed below:

NOTE: Not more than 4 corners, all in the same town and range, may be recorded on this certificate.

A. Description of original monument and accessories and/or subsequent restoration:

E-9 Section Corner for Sections 20, 21, 28 and 29, T18N, R15W.

Sylvester Sibley, 1838, G.L.O.
Set Wood post
#1 Beech 12" S56°E 111ks.(7.26')
#2 Pine 16" S84°W 101ks.(6.60')

Charles Landon, (pre 1940)
1 1/2" Iron pipe
#3 Twin Elm 6" & 8" N63°W 571ks.(37.62')
#4 Maple 12" S04°W 1331ks.(

#7 W. Oak 6" North 25.57'
Carl Roser, 1978, #12028
Found 1 1/2" Iron Pipe
#9 J. Pine 13" N55°W 62.35'
#10 Maple 5" N20°W 40.98'
#11 W. Oak 7" N25°E 25.57'
Ken Stephens, no date
Monu. not given

R.O. Towns, MCS, 1902
Stone, Book 2, Pg.,33
Mason Co. Records

Ken Ross, M.C.S., 1977
Found 1 1/2" Iron Pipe
#5 J. Pine N70°W 62.41'
#6 Maple 6" N45°W 44.00'

B. Description of corner evidence found and/or method applied in restoring or reestablishing corner:

E-9 Section Corner for Sections 20, 21, 28 and 29, T18N, R15W.

On July 16, I found a 1 1/2" Iron Pipe, found no evidence to dispute this location for the corner.

#8 R. Oak 14" S 38° W 195 1/2ks. (129.03')
#9 J. Pine 8" N 59° W 941ks. (62.04')
Ros er cont.
#12 W. Pine 4" S70°E 55.80'

Condition of recorded witnesses are;

- | | | |
|------------------------|----------------------------|-----------------------------|
| #1 Gone | #6 Found in good condition | #11 Same as 7 |
| #2 Gone | #7 Found in good condition | #12 Found in good condition |
| #3 Gone | #8 Found in good condition | |
| #4 Gone | #9 Same as 5 | |
| #5 Found, tree is down | #10 Same as 5 | |
| | #10 Same as 6 | |

C. Description of monument for corner and accessories established to perpetuate locating the position of the corner:

E-9 Section Corner for Sections 20, 21, 28 and 29, T18N, R15W.

I placed a Standard Mason County Monument inside the existing 1 1/2" Iron pipe, 0.2 foot above the ground surface, And is accepted as a faithful and careful reestablishment of the position of the original corner.
Pine Post 1.10' NE of Pipe & Monument

- (ext. BT #6) Maple 6" N 20° W 41.06'(60d spike in SW side of tree)
- (ext. BT #7) White Oak 8" N.22°E 25.57'(60d spike in West side of tree)
- White Oak 6" S 30° W 17.20'(60d spike in NW side of tree)
- White Oak 7" S 40° E 38.15'(60d spike in SW side of tree)

Signed by Sammy S. Barnett
Surveyor's Michigan License No. 16923

Peer Group Reviewed and Approved
Date: 8-12-96
Kenneth L. Ross
Mason County Surveyor

FORM APPROVED BY MICHIGAN BOARD OF LAND SURVEYORS, JAN. 28, 1971
REVISED MAY 14, 1975
REVISED JAN., 1983

