

SURVEY & REMONUMENTATION


OCT 30 1996 LAND CORNER RECORDATION CERTIFICATE

Filing Requirement of Act 74, Mich. P.A. 1970

For corners in

COMMISSION

MASON <small>(County)</small>	Located In:	Corner Code #/
1. Public Land Survey	T 18 N. R 15 W	E-11
	T _____ R _____	_____
	T _____ R _____	_____
	T _____ R _____	_____
2. Property Controlling in Section	S _____ T _____ R _____	_____
	S _____ T _____ R _____	_____
3. Miscellaneous Property in Sec.	S _____ T _____ R _____	_____
	S _____ T _____ R _____	_____

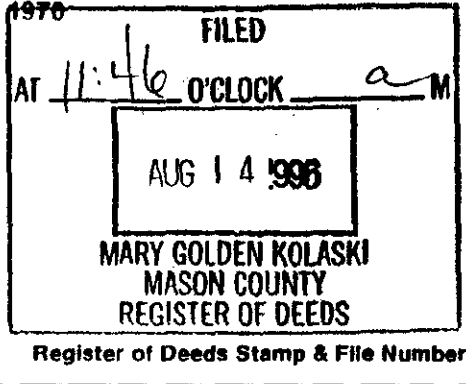

4. Lot No. _____, Recorded Plat _____
5. Private Claims _____

I, Sammy S. Barnett, in a field survey on July 17, 1996, do hereby certify that under requirements of P.A. 74, Michigan P.A. of 1970, the corner points mentioned in lines 1 and 2 above were in conformance with regulations and rules therefore as required in the current manual of survey instructions of the United States Department of the Interior, Bureau of Land Management or by a decree of a Court of Law and/or that the corner points mentioned in lines 3, 4 and 5 above were in conformance with the rules of the Michigan Board of Land Surveyors or by a Decree of a Court of Law, established, re-established, monumented, re-monumented, recovered, found as expressed below:

NOTE: Not more than 4 corners, all in the same town and range, may be recorded on this certificate.

	A	B	C	D	E	F	G	H	I	J	K	L	M
2	6	5	4	3	2	1							
3													
4	7	8	9	10	11	12							
5													
6	18	17	16	15	14	13							
7													
8	19	20	21	22	23	24							
9													
10	30	29	28	27	26	25							
11													
12	31	32	33	34	35	36							
13													

A. Description of original monument and accessories and/or subsequent restoration:

E-11 Section for Sections 28, 29, 32 and 33, T18N, R15W.

Sylvester Sibley, 1838, G.L.O.

Set Wood Post

#1 Pine 6" N66°E 331ks.(21.78')

#2 Pine 6" S49°W 101ks.(6,60')

Charles Landon, no date

RR Iron for Corner

P. Aman, USFS, 1940

RR Iron

#3 White Oak 10" S10°E 201ks.(13.20')

#4 White Oak 12" S27° 921ks.(60.72')

#5 Jack Pine 7" N30°W 1101ks.(72.60')

Ken Stephens, Corner Card, no date

Stone

#6 Birch 18" S34°E 55.20'

#7 Norway 8" S70½°W 66.00'

#8 Poplar 6" N32°W 48.00'

Sam Barnett, RLS, 1972

Found Brass Cap Conc. Mon.

#9 Oak 8" S31°W 42.58'

#10 Oak 6" N50°E 106.62'

#11 R. Pine 12" S37°E 187.36'

Robert Griffin, RLS, 1983

Conc. Monument 5" x 5'

#12 W. Oak 4" N04°W 37.10'

B. Description of corner evidence found and/or method applied in restoring or reestablishing corner:

E-11 Section Corner for Sections 28,29, 32 and 33, T18N, R15W.

OVER

On July 17, I found a concrete monument by R. A. Griffffin, 1 foot below the Surface of two-track road USFS trail road 1,5 South of center-line, I found no evidence to dispute this location for the corner.

Condition of recorded witnesses are;

#1 Gone

#2 Gone

#3 Gone

#4 Gone

#5 Gone

#6 Gone

#7 Gone

#8 Gone

#9 Found in good condition

#10 Could not find

#11 Found in good condition

#12 Found in good condition

#13 Gone

#14 Gone

#15 Gone

C. Description of monument for corner and accessories established to perpetuate locating the position of the corner:

E-11 Section Corner for Sections 28, 29, 32, and 33, T18N, R15W.

I accepted 5' square x 5 foot long Concrete monument, with brass disk as a substancial marker for the corner and is accepted as a careful and faithful reestablishment of the position of the original corner.

(ext. BT #9) Black Oak 12" S 31° W 42.56'(60d spike in NW side of tree)

(ext. BT #11) Red Pine 14" S 37° E 187.36'(60d spike in NE side of tree)

(ext. BT #12) White Oak 6" N 04° W 36.85'(60d spike in West side of tree)

(ext. BT) Jack Pine 8" N 45° W 56.17'(60d spike in NE side of tree)

Signed by Sammy S. Barnett
Surveyor's Michigan License No. 16923

Date 8-17-96

Peer Group Reviewed
and Approved
Date: 8-13-96
Kenneth L. Ross
Mason County Surveyor



FORM APPROVED BY MICHIGAN STATE BOARD OF LAND SURVEYORS, JAN. 28, 1971
REVISED MAY 14, 1975
REVISED JAN. 1983

E-11

CONT:

1963, Mason County Road Comm.

"I" Iron

#13 L. Oak 6" NE 37.10'
#14 Twin Oak 12" East 68.80'
#15 L. Oak 12" South 13.20'

SURVEY &
REMONUMENTATION

OCT 30 1996

COMMISSION