LAND CORNER RECORDATION CERTIFICATE

Filing Requirement of Act 74, Mich. P.A. 1970

FILED
AT 10:35 O'CLOCK
OCT 13 1994
MARY GOLDEN KOLASKI
MASON COUNTY
REGISTER OF DEEDS

For corners in

MASON (County)

Located In: Corner Code 11

1. Public Land Survey — T 18N R 15W — F-5
   T R
   T R
   T R
2. Property Controlling — S T R
   in Section — S T R
3. Miscellaneous — S T R
   Property in Sec. — S T R

Seg. 1

Register of Deeds Stamp & File Number

4. Lot No. _____, Recorded Plat _____
5. Private Claims _____

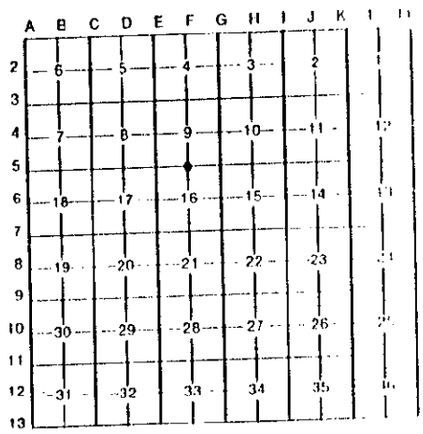

I, John Schulke, in a field survey on Aug. 30, 1994, do hereby certify that under requirements of P.A. 74, Michigan P.A. of 1970, the corner points mentioned in lines 1 and 2 above were in conformance with regulations and rules therefore as required in the current manual of survey instructions of the United States Department of the Interior, Bureau of Land Management or by a decree of a Court of Law and/or that the corner points mentioned in lines 3, 4 and 5 above were in conformance with the rules of the Michigan Board of Land Surveyors or by a Decree of a Court of Law; established, re-established, monumented, re-monumented, recovered, found as expressed below:

NOTE: Not more than 4 corners, all in the same town and range, may be recorded on this certificate.

A. Description of original monument and accessories and/or subsequent restoration:

Original survey established in 1838 by Sibley.
Set a wooden post with the following references:

1. 16" Pine — S75°E — 9 lks.
2. 10" Pine — N85°W — 6 lks.

In 1904, R.O. Towns located the corner by NW pine tree (see #2 above) and planted a strap iron (see Book 2, page 140 & 141). The following corner references:

3. NW corner of Section 16 — West — 39.88 chains (2632.1')
4. NE corner of Section 16 — East — 40.56 chains (2677')
5. C 1/4 corner of Sec. 16 — South 38.92 chains (2568.7')

In 1975, Clint Cole found strap iron set by R.O. Towns (see RCS Liber 1, Page 357). The following corner references:

6. NW corner of Sec. 16 — N87°50'58"W — 2637.46' (CMPI)
7. C 1/4 corner of S 16 — S0°36'49"W — 2569.72' (CMPI)
8. Concrete monument by Stephen's — North — 92.83 ft.
9. 6" W Oak — N66°W — 33.01 ft.
10. 10" W Oak — S60°W — 36.54 ft.
11. 6" Blk. Oak — S56°E — 55.38 ft.

B. Description of corner evidence found and/or method applied in restoring or reestablishing corner:

Found 3"X1/2"X36" (thought to be wagon tongue) with bottom bent.
Also found broken pottery and glass around iron. Found the following corner references:

Decayed pine stump	N85°W	4 ft.	(see #2 above)
Monument (at fence corner)	North	92.83 ft.	(see #8 above)
11" W. Oak	N60°W	32.93 ft.	(see #10 above)
16" W. Oak	S69°W	36.51 ft.	(see #9 above)
10" Blk. Oak	S54°E	55.56 ft.	(see #11 above)

C. Description of monument for corner and accessories established to perpetuate locating the position of the corner:

Replaced iron with 5/8"X36" rebar with an aluminum County cap.
Buried broken glass & pottery around rebar and set iron on the East side of rebar. The Following new corner references:

12" W. Oak	N82°E	51.20 ft.	16" W. Oak	S69°W	36.51 ft.
11" W. Oak	N60°W	32.93 ft.	10" Blk. Oak	S54°E	55.56 ft.

(NOTE: Corner is accepted as the best evidence of the perpetuated location of the original corner.)

STATE OF MICHIGAN — JOHN C. SCHULKE — LAND SURVEYOR — No. 30894 — LICENSED LAND SURVEYOR

Signed by John C. Schulke Date Oct. 5, 1994

Surveyor's Michigan License No. PLS-30894

Peer Group Reviewed and Approved
Date: Oct 5, 1994
Kenneth L. Ross
County Surveyor

FORM APPROVED BY MICHIGAN STATE BOARD OF LAND SURVEYORS, JAN 28 1961
REVISED MAY 14 1966
REVISED JAN 1968