

SURVEY & REMONUMENTATION

APR 28 1995

COMMISSION

LAND CORNER RECORDATION CERTIFICATE Filing Requirement of Act 74, Mich. P.A. 1970

For corners in

<u>MASON</u> (County)	Located In:	Corner Code: <i>ff</i>
1. Public Land Survey	T 18N R 15W	G-5
	T _____ R _____	_____
	T _____ R _____	_____
	T _____ R _____	_____
2. Property Controlling in Section	S _____ T _____ R _____	<i>Seg. 1</i>
	S _____ T _____ R _____	_____
3. Miscellaneous Property in Sec.	S _____ T _____ R _____	_____
	S _____ T _____ R _____	_____

FILED

AT 10:35 O'CLOCK a M

OCT 13 1994

MARY GOLDEN KOLASKI
MASON COUNTY
REGISTER OF DEEDS

Register of Deeds Stamp & File Number

4. Lot No. _____, Recorded Plat _____

5. Private Claims _____

I, John Schulke, in a field survey on Aug. 30, 1994, do hereby certify that under requirements of P.A. 74, Michigan P.A. of 1970, the corner points mentioned in lines 1 and 2 above were in conformance with regulations and rules therefore as required in the current manual of survey instructions of the United States Department of the Interior, Bureau of Land Management or by a decree of a Court of Law and/or that the corner points mentioned in lines 3, 4 and 5 above were in conformance with the rules of the Michigan Board of Land Surveyors or by a Decree of a Court of Law; established, re-established, monumented, re-monumented, recovered, found as expressed below:

A	B	C	D	E	F	G	H	I	J	K	L	M
2	6	5	4	3	2	1						
3												
4	7	8	9	10	11	12						
5												
6	18	17	16	15	14	13						
7												
8	19	20	21	22	23	24						
9												
10	30	29	28	27	26	25						
11												
12	31	32	33	34	35	36						
13												

NOTE: Not more than 4 corners, all in the same town and range, may be recorded on this certificate.

A. Description of original monument and accessories and/or subsequent restoration:

Original survey established in 1838 by Sibley.
Set a wooden post with the following corner references:
14" W. Oak S21°W 52 lks.
10" W. Oak N57°E 11 lks.
In 1904, R.O. Towns found 3/4" iron pipe from survey of Section 10 (see Book 2, page 141 of the Co. Surveyor's record book).

is 1373.4 ft.

In 1992, recorded a survey of Lot 24 of the Unrecorded Plat of Ka-No-Ge-Mog Resort (see Liber 422, page 305). The distance measured to the W 1/16th corner of Sections 10 and 15 is 1372.59 ft.


In 1910, Unrecorded Plat of Ka-No-Ge-Mog Resort was done by W.H. Read. He found 3/4" gas pipe at the intersection of road (road running North, South & West). Distance to the West 1/8 corner of Sections 10 & 15

B. Description of corner evidence found and/or method applied in restoring or reestablishing corner:

Found 3/4" iron bar in monument box.
Found the following corner references:
Plat monument West 33.15 ft.
8" Blazed Cherry S49°E 61.52 ft.
(Top Dead)
13" Blazed W. Oak N38°E 61.69 ft.
14" Blazed W. Oak N47°W 38.87 ft.
Power Pole N46°E 45.13 ft.

C. Description of monument for corner and accessories established to perpetuate locating the position of the corner:

Placed an aluminum County cap to identify the corner (placed County cap over 3/4" iron-enlarged to fit).
The following new corner references:
4"X4" Sq. Post N82°W 32.16 ft. 13" Blazed W. Oak N38°E 61.69 ft.
13" Blazed R. Oak S59°E 81.86 ft. (see column B)
NE corner of Garage S59°W 116.76 ft.
Plat monument (4" dia.) West 33.15 ft. (see above)
(NOTE: Corner is accepted as the best evidence of the perpetuated location of the original corner.)

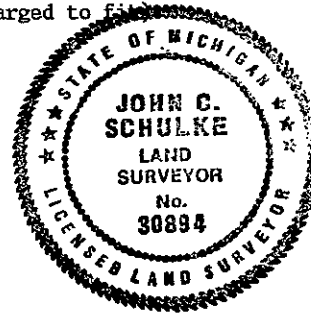

Signed by John C. Schulke Date Oct 5, 1994
Surveyor's Michigan License No. PLS-30894

Peer Group Reviewed and Approved
Date: Oct 5, 1994
Kenneth L. Ross
Mason County Surveyor

FORM APPROVED BY MICHIGAN STATE BOARD OF LAND SURVEYORS, JAN. 28, 1971
REVISED MAY 14, 1975
REVISED JAN., 1983