

FEB 08 2000

LAND CORNER RECORDATION CERTIFICATE

Filing Requirement of Act 74, Mich. P.A. 1970

SECTION

For corners in

MASON
(County)

Located In:

Corner Code #

- 1. Public Land Survey T 18N R 15W I-1
- T _____ R _____
- T _____ R _____
- T _____ R _____
- 2. Property Controlling S _____ T _____ R _____
- in Section S _____ T _____ R _____
- 3. Miscellaneous S _____ T _____ R _____
- Property in Sec. S _____ T _____ R _____

FILED

AT 1:26 O'CLOCK P M.

JUL 22 1999

MARGARET KOLASKI ELLIOTT
MASON COUNTY
REGISTER OF DEEDS

Register of Deeds Stamp & File Number

- 4. Lot No. _____, Recorded Plat _____
- 5. Private Claims _____

I, Kenneth L. Ross, in a field survey on June 5, 1999, do hereby certify that under requirements of P.A. 74, Michigan P.A. of 1970, the corner points mentioned in lines 1 and 2 above were in conformance with regulations and rules therefore as required in the current manual of survey instructions of the United States Department of the Interior, Bureau of Land Management or by a decree of a Court of Law and/or that the corner points mentioned in lines 3, 4 and 5 above were in conformance with the rules of the Michigan Board of Land Surveyors or by a Decree of a Court of Law; established, re-established, monumented, re-monumented, recovered, found as expressed below.

NOTE: Not more than 4 corners, all in the same town and range, may be recorded on this certificate.

A. Description of original monument and accessories and/or subsequent restoration:

- I-1, Corner Common to Sections 2 and 3, T.18N., R.15W.,
GLO, 2nd quarter 1838 1906, W.E. Metcalf, Book 4, page 160
Mullet and Brookfield "R.R. Fish Plate" No Witnesses
Nbdy, 34 links east of post (22.44') 1 1/4" Tube West, 22.44'
White Oak, 16", Cor Secs. 2 & 3 Distance West to H-1, 2678.94'
No Witnesses Given Distance South to I-2, 2700.72'
- 1904, R.O. Towns, Book 2, page 136 & 137 October, 1968, Dwg. 125,
"Located Corner by measuring 34 K.B. Stephens, "Set 1" Pipe"
Links East from Corner Secs. 34 I-13, T.19N., R.15W., West, 22.49'
And 35, Set Iron" No Witnesses No Witnesses Given.
- March, 1993, K.L. Ross, Field Notes, No Comment on Corner
No Witnesses Given
Distance West to H-1, 2650.93'
Distance South to I-2, 2684.43'

	A	B	C	D	E	F	G	H	I	J	K	L	M
1													
2	6	5	4	3	2	1							
3													
4	7	8	9	10	11	12							
5													
6	18	17	16	15	14	13							
7													
8	19	20	21	22	23	24							
9													
10	30	29	28	27	26	25							
11													
12	31	32	33	34	35	36							
13													


- June, 1973, LCRC, Liber 1, page 169
- Robert A. Griffin, "Fd. 1" pipe by Stephens, replaced in the exact location with a 5" square X 36" Concrete Monument, 1' below the road Surface"
- (1) 16d spike and brass tag, NW side 4" sq. post, South, 33.05'
- (2) 10" dock spike, SE side, P.P. S60°W, 57.21'
- (3) 10" dock spike, NW side W. Oak, 6", S37°W, 103.25'
- (4) SW Corner Sec. 34, T.19N., R.15W West 22.40'
- (5) Center of 2" square cut in top of stone 3'X3', 1.5' above the ground, N34°W, 88.86'

B. Description of corner evidence found and/or method applied in restoring or reestablishing corner:

I-1, Corner Common to Sections 2 and 3, T.18N., R.15W.,
I found the 5" square Concrete Monument as described by Robert A. Griffin above, about 8" below the gravel surface of and on the South edge of Decker Road about 22 feet East of the Center-line of Taylor Road to the North. Witnesses (1), (3), (4) and (6) have been destroyed by Road Construction. Witnesses (2) and (5) are standing and in Good condition. I found no other evidence to dispute the location of this corner.

C. Description of monument for corner and accessories established to perpetuate locating the position of the corner:

- I-1, Corner Common to Sections 2 and 3, T.18N., R.15W.,
I left the 5" square Concrete Monument in place as set by R.O. Griffin in 1973 and described above and accepted this location as careful and faithful re-establishment of the original corner.
- (3) Existing 16d spike, and brass tag, west side of 4" X 4" treated post, South 33.05'
- (4) Corner I-13 T.19N., R.15W., USFS Conc Monument, West, 22.40'
- (7) NBT Existing 60d sike SE side of Maple Clump, 6"-12", N32°E, 145.25'
- (8) Set 60d spike, SE side of 12" Red Oak, N51°W, 165.55'
- (9) Set 60d Spike, SE side of P.P. S62°W, 66.62'
- Note: as stated above this corner is located on the South side of the Gravel Surface of Decker Road and about 22 feet East of the center-line of Taylor Road to the North.

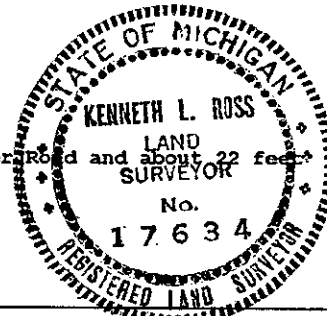

Signed by *Kenneth L. Ross* Date 7-21-99

Surveyor's Michigan License No. 17634

Peer Group Reviewed and Approved
Date: 7-14-99
Kenneth L. Ross
Kenneth L. Ross
Mason County Surveyor