

FEB 08 2000

LAND CORNER RECORDATION CERTIFICATE

Filing Requirement of Act 74, Mich. P.A. 1970

SECTION

For corners in

MASON

(County)

Located In:

Corner Code #

- | | | | | | |
|------------------------------------|---|-----|---|-----|-----|
| 1. Public Land Survey | T | 18N | R | 15W | J-1 |
| | T | | R | | |
| | T | | R | | |
| | T | | R | | |
| 2. Property Controlling in Section | S | T | R | | |
| | S | T | R | | |
| 3. Miscellaneous | S | T | R | | |
| Property in Sec. | S | T | R | | |

FILED

AT 1:25 O'CLOCK P M

JUL 22 1999

MARGARET KOLASKI ELLIOTT
MASON COUNTY
REGISTER OF DEEDS

Register of Deeds Stamp & File Number

4. Lot No. _____, Recorded Plat _____
5. Private Claims _____

I, Kenneth L. Ross, in a field survey on June 5, 1999, do hereby certify that under requirements of P.A. 74, Michigan P.A. of 1970, the corner points mentioned in lines 1 and 2 above were in conformance with regulations and rules therefore as required in the current manual of survey instructions of the United States Department of the Interior, Bureau of Land Management or by a decree of a Court of Law and/or that the corner points mentioned in lines 3, 4 and 5 above were in conformance with the rules of the Michigan Board of Land Surveyors or by a Decree of a Court of Law; established, re-established, monumented, re-monumented, recovered, found as expressed below:

NOTE: Not more than 4 corners, all in the same town and range, may be recorded on this certificate.

A. Description of original monument and accessories and/or subsequent restoration:
J-1, N ¼ Corner Section 2, T.18N., R.15W.

Corner not set by GLO
May, 1904, Book 2, Page 136 & 137
R.O. Towns, "Set quarter Post by Measurement", No Witnesses
Distance West to I-1, 2641.32'
Distance East to K-1, 2641.32'

October, 1968, K.B. Stephens
Dwg. D-125, "Set 1" pipe, 18.53'
East of S1/4 cor Sec. 35, T.19N., R.15W., Distance West to I-1, 2646.10'

June, 1973, LCRC, Liber 1, page 173, Robert A. Griffin Stated that he use this corner to establish corner K-1 T.18N., R.15W., by using this corner and recovered corner I-1, T.18N., R.15W and projecting them to the East.
Distance from J-1 west to I-1, 2640.75'
Distance from J-1 east to K-1, 2640.75'
No Witnesses for this corner are recorded.

B. Description of corner evidence found and/or method applied in restoring or reestablishing corner:
J-1, N ¼ Corner Section 2, T.18N., R.15W.,

I found a 1" X 24" galvanized iron pipe as described by Stephens, 6" below the gravel surface. J-13, T.19N., R.15W., Is West 18.53'. I found no other evidence to dispute the location of this corner. During the research for this corner I found no Witnesses, but, there are existing witnesses in the area that are unrecorded.

C. Description of monument for corner and accessories established to perpetuate locating the position of the corner:
J-1, N ¼ Corner Section 2, T.18N., R.15W.,

I replaced the 1" X 24" galvanized iron pipe in the exact location with a standard 3" Cast Iron Mason County Monument on the center-line and 1.0' below the surface of Decker Road. This position not established by original government surveyors. This monument is accepted as the best available evidence of the position of the corner.

- (1) Set 60d spike, SE side, 6" Sassafras, N45°E, 41.04'
- (2) Property Iron and Nordlund Cap, N25°W, 38.05'
- (3) Existing 60d spike, East Side, 12" Red Oak, N31°W, 40.96'
- (4) Existing 60d spike, East side, 15" Red Oak, S02°E, 86.12'
- (5) Corner J-13, T.19N., R.15W., West, 18.53'
- (6) Distance West to I-1, 2640.75' (Griffin)
- (7) Distance East to K-1, 2640.75' (Griffin)

1	A	B	C	D	E	F	G	H	I	J	K	L	M
2		6		5		4		3		2		1	
3													
4		7		8		9		10		11		12	
5													
6		18		17		16		15		14		13	
7													
8		19		20		21		22		23		24	
9													
10		30		29		28		27		26		25	
11													
12		31		32		33		34		35		36	
13													

Signed by [Signature]

Date 7-21-99


Surveyor's Michigan License No. 17634

Peer Group Reviewed and Approved

Date: 7-21-99
[Signature]
Kenneth L. Ross

FORM APPROVED BY MICHIGAN STATE BOARD OF LAND SURVEYORS, JAN. 28, 1978
REVISED MAY 14, 1978
REVISED JAN., 1988
ADAPTED FOR WORD PROCESSING MARCH, 1998

LIBER

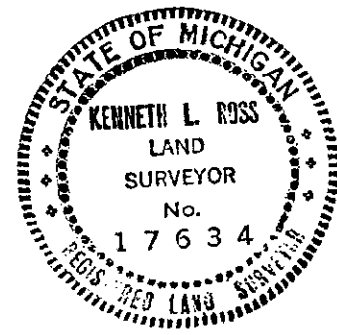

4 PAGE 207