

FEB 08 2000

SECTION

LAND CORNER RECORDATION CERTIFICATE

Filing Requirement of Act 74, Mich. P.A. 1970

FILED
AT 1:25 O'CLOCK P M
JUL 22 1999
MARGARET KOLASKI ELLIOTT
MASON COUNTY
REGISTER OF DEEDS

For corners in MASON Located In: _____ Corner Code # _____
(County)

1. Public Land Survey T 18N R 15W _____ K-1
T _____ R _____
T _____ R _____
T _____ R _____

2. Property Controlling S _____ T _____ R _____
in Section S _____ T _____ R _____

3. Miscellaneous S _____ T _____ R _____

Property in Sec. S _____ T _____ R _____

Register of Deeds Stamp & File Number

4. Lot No. _____, Recorded Plat _____
5. Private Claims _____

1														
2	6	5	4	3	2	1								
3														
4	7	8	9	10	11	12								
5														
6	18	17	16	15	14	13								
7														
8	19	20	21	22	23	24								
9														
10	30	29	28	27	26	25								
11														
12	31	32	33	34	35	36								
13														

I, Kenneth L. Ross, in a field survey on June 5, 1999, do hereby certify that under requirements of P.A. 74, Michigan P.A. of 1970, the corner points mentioned in lines 1 and 2 above were in conformance with regulations and rules therefore as required in the current manual of survey instructions of the United States Department of the Interior, Bureau of Land Management or by a decree of a Court of Law and/or that the corner points mentioned in lines 3, 4 and 5 above were in conformance with the rules of the Michigan Board of Land Surveyors or by a Decree of a Court of Law; established, re-established, monumented, re-monumented, recovered, found as expressed below:

NOTE: Not more than 4 corners, all in the same town and range, may be recorded on this certificate.

A. Description of original monument and accessories and/or subsequent restoration:
K-1, Corner Common to Sections 1 and 2, T.18N., R.15W.,
GLO, 2nd quarter, 1838 December 1917, Book 2, page 219
Mullet and Brookfield C.E. Mitchell, "Fd. Stake to Secs.
Nbndy, 22 links East of post (14.52') 35 & 36, measured East 22 links,
(1) Beech, 10", S10°E, 20 links(13.20') set stake, No Witnesses"
(2) Maple, 8", S21°W, 38 links(25.08') Distance East to L-1, 2628.78'
Distance South to J-2, 2991.12'

May, 1904, Book 2, page 136 and 137
R.O. Towns, "Established by measuring
East, 22 links, from SE Cor. Sec. 35"
No Witnesses Given.
Distance West to J-1, 2641.32'
Distance South to J-2, 2979.24'

June, 1973, LCRC, Liber 1, page 173, Robert A. Griffin, "Established on a
straight line between the recovered NW cor. and the recovered N ¼ cor.
which measured 2640.75 feet. Then projected a transit line from the NW
Corner through the N1/4 Corner and established a point on this line
2640.75' east of the N1/4 Corner and placed a 5" square X 36" Concrete
Monument, 1.0' below the road surface. (See Recorded LCRC for further
Information).

- (3) Spike and brass tag in P.P., S36°E, 80.05'
- (4) Spike and brass tag in 4" square post, South 32.90'
- (5) 10" dock spike, east side of White Oak, 7", S08°W, 114.95'
- (6) 10" dock spike, SW side of White Oak, 7", S27°E, 122.98'
- (7) Corner K-13, T.19N., R.15W., West, 14.52'


B. Description of corner evidence found and/or method applied in restoring or reestablishing corner:
K-1, Corner Common to Sections 1 and 2, T.18N., R.15W.,

Found USFS Monument by Griffin as described above, 6" below the road surface. Witnesses (1), (2), (5) and (6) Have been destroyed. Witnesses (3), (4) and (7) are standing and in good condition. I found no other evidence to Dispute the location of this corner.

C. Description of monument for corner and accessories established to perpetuate locating the position of the corner:

K-1, Corner Common to Sections 1 and 2, T.18N., R.15W.,
I left the 5" square USFS monument as described by Griffin above in place in the center-line of Decker Road and accepted this as a careful and faithful re-establishment of the original corner.

- (3) existing 60d spike in SW side of P.P. S34°E, 80.00'
- (4) existing nail and brass cap, West side of 4" square treated post, South, 32.90'
- (7) Corner K-13, T.19N., R.15W., West, 14.52'
- (8) NBT, Existing Dock Spike, SW side of Triple 12"-12"-8", Maple, N30°W, 42.09'
- (9) NBP, Set 60d spike, SE side P.P. S70°W, 88.85'
- (10) NBT, Existing 16d spike, NW side of 10" White Pine, N15°E, 43.91'

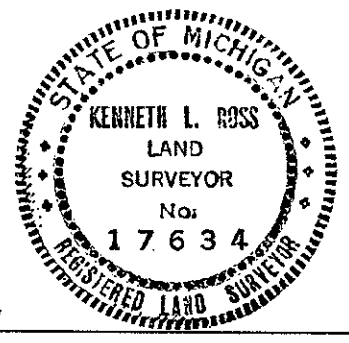

Signed by [Signature]

Date 7-21-99

Surveyor's Michigan License No. 17634

Peer Group Reviewed
and Approved
Date: 7-14-99
[Signature]
Kenneth L. Ross

LIBER

4 PAGE 266