

FEB 08 2000

LAND CORNER RECORDATION CERTIFICATE

Filing Requirement of Act 74, Mich. P.A. 1970

SECTION

For corners in
MASON
 (County)

Located In:

Corner Code #

FILED
 AT 1:24 O'CLOCK P M
 JUL 22 1999
 MARGARET KOLASKI ELLIOTT
 MASON COUNTY
 REGISTER OF DEEDS
 Register of Deeds Stamp & File Number

- 1. Public Land Survey T 18N R 15W L-1
 T R
 T R
 T R
- 2. Property Controlling S T R
 in Section S T R
- 3. Miscellaneous S T R
- Property in Sec. S T R

- 4. Lot No. _____, Recorded Plat _____
- 5. Private Claims _____

I, Kenneth L. Ross, in a field survey on June 5, 1999, do hereby certify that under requirements of P.A. 74, Michigan P.A. of 1970, the corner points mentioned in lines 1 and 2 above were in conformance with regulations and rules therefore as required in the current manual of survey instructions of the United States Department of the Interior, Bureau of Land Management or by a decree of a Court of Law and/or that the corner points mentioned in lines 3, 4 and 5 above were in conformance with the rules of the Michigan Board of Land Surveyors or by a Decree of a Court of Law; established, re-established, monumented, re-monumented, recovered, found as expressed below:

NOTE: Not more than 4 corners, all in the same town and range, may be recorded on this certificate.

A. Description of original monument and accessories and/or subsequent restoration:

L-1, N ¼ Corner Section 1, T.18N., R.15W.,
 Corner was not set by GLO
 December, 1917, Book 2, page 219
 C.E. Mitchell, No Comment on Corner
 Distance West to K-1, 2628.78'
 Distance East to M-1, 2628.78'

June, 1972, LCRC, Liber 1, page 72, Robert A. Griffin, "Set corn Half way and on a straight line between the NE and NW Corner of Section, Distance West to K-1, 2628.30', Distance East to M-1, 2628.30'. Set 5" square X 36" USFS Monument, 1.0' below the road surface.
 (1) 10" dock spike side of Maple, 10", S28°E, 110.30'
 (2) 10" dock spike, E. side Red Pine, 12", S04°E, 116.65'
 (3) spike and brass tag, E. side, 4" sq. post, South, 33.48'
 (4) spike and brass tag, S side P.P., S82°W, 259.30'

B. Description of corner evidence found and/or method applied in restoring or reestablishing corner:

L-1, N ¼ Corner Section 1, T.18N., R.15W.,

I found a broken 5" square USFS Monument as described by Robert Griffin above. Witnesses (1), (2) have been destroyed due to Power Line construction in the recent year. Witnesses (3) and (4) are standing and in good condition. I found no other evidence to dispute the location of this corner.


C. Description of monument for corner and accessories established to perpetuate locating the position of the corner:

L-1, N ¼ Corner Section 1, T.18N., R.15W.,
 I removed the broken 5" square Concrete Monument as set by Robert A. Griffin and set in the exact location a 3" standard Mason County Harrison Monument, 1.0' below the road surface. This position not established by original government surveyors. This monument is accepted as the best available evidence of the position of the corner.
 (3) Existing 6d spike and brass tag, East side, 4" square treated post, South, 33.48'
 (4) Existing 6d spike and brass tag, South side of P.P. S82°W, 259.30'
 (5) NBP, Set 60d spike in South side P.P. S80°E, 64.58'
 (6) NBT, Set 60d spike in SW side of 12" Maple, N25°W, 74.83'
 (7) NBT, Set 60d spike in West side of 18" Red Oak, N41°E, 98.85'
 (8) NBT, Set 60d spike in West side of 10" White Pine, N19°E, 103.09'
 (8) Corner L-13, T.19N., R.15W., West, 7.73' (existing Mason County Monument, 3" aluminum)
 Note: Corner is 8 foot East of the center-line of Lanager Road to South and 25 foot South of the center-line of Decker Road.

Signed by [Signature]

Date 7-21-99

Surveyor's Michigan License No. 17634

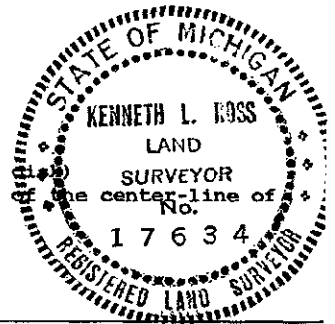

FORM APPROVED BY MICHIGAN STATE BOARD OF LAND SURVEYORS, JAN. 21
 REVISED MAY 1
 REVISED JAN
 ADAPTED FOR WORD PROCESSING MARC

Peer Group Reviewed
 and Approved
 Date: 7-14-99
[Signature]
 Kenneth L. Ross
 Mason County Surveyor

LIBER

4 PAGE 265