


MAR 16 1998

**SECTION**

**LAND CORNER RECORDATION CERTIFICATE**  
Filing Requirement of Act 74, Mich. P.A. 1970

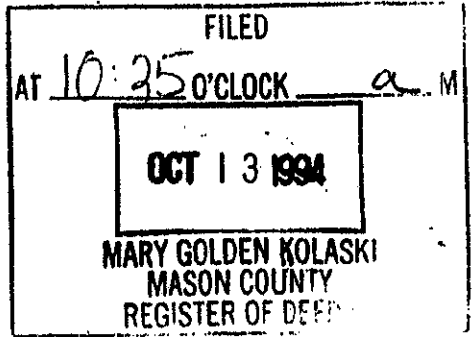

For corners in

MASON (County)	Located In:	Corner Code #:
1. Public Land Survey	T 18N R 15W	E-7
	T R	
	T R	
	T R	
2. Property Controlling In Section	S T R	Sec. 2
	S T R	
3. Miscellaneous Property in Sec.	S T R	
	S T R	

4. Lot No. \_\_\_\_\_, Recorded Plat \_\_\_\_\_  
5. Private Claims \_\_\_\_\_

Register of Deeds Stamp & File Number

	A	B	C	D	E	F	G	H	I	J	K	L	M
2	6	5	4	3	2	1							
3													
4	7	8	9	10	11	12							
6													
8	18	17	16	15	14	13							
7													
8	19	20	21	22	23	24							
9													
10	30	29	28	27	26	25							
11													
12	31	32	33	34	35	36							
13													

I, John Schulke, in a field survey on Aug. 25, 1994, do hereby certify that under requirements of P.A. 74, Michigan P.A. of 1970, the corner points mentioned in lines 1 and 2 above were in conformance with regulations and rules therefore as required in the current manual of survey instructions of the United States Department of the Interior, Bureau of Land Management or by a decree of a Court of Law and/or that the corner points mentioned in lines 3, 4 and 5 above were in conformance with the rules of the Michigan Board of Land Surveyors or by a Decree of a Court of Law; established, re-established, monumented, re-monumented, recovered, found as expressed below:

**NOTE: Not more than 4 corners, all in the same town and range, may be recorded on this certificate.**

**A. Description of original monument and accessories and/or subsequent restoration:**

Original survey established in 1838 by Sibley.

Set a wooden post with the following corner references:

- 1. 14" Pine N07°W 16 lks.
- 2. 10" Beech S30°E 19 lks.
- 3. Line Tree (20" Pine) North 9.90 chains

In 1909, recorded plat of Walhalla by R.O. Towns (see Liber 1 of Plats, page 68).

POB East on Section line 200 ft. (see 7) 1/4 corner of Section 16 & 21 East 2666 ft. 1/8 corner South 1332 ft.

In 1904, R.O. Towns found line tree 9.90 chns. North & set an iron and marked the pine stumps (see Book 2, Pages 140 & 141). The following corner references:

- 4. 15" pine stump S51°W 48 lks.
- 5. 18" pine stump N51°W 27 lks.
- 6. 1/4 corner North 39.90 chains (2633.4')
- 7. 1/4 corner East 40.34 chains (2662.4')

Unlisted date (1949), Railroad Map-"Walhalla" done by the railroad with the following information:

- 9. Section corner (center line of road) is West 139.4 ft. of the East center line of railroad track.
- 10. 1/4 corner South 2634.16 ft.
- 11. 1/8 corner South 1317.3 ft.

**B. Description of corner evidence found and/or method applied in restoring or reestablishing corner:**

CONTINUE ON BACK

Recovered monument with brass cap (6" below the surface of road)  
Recovered the following corner references:


- see #8
- 14 (South 32.89 ft.)
- 16 & 19 (N26°W 146.82 ft.)
- 12 & 17 (N04°W 34.00 ft.)
- 18 (S75°E 65.45 ft.)

**C. Description of monument for corner and accessories established to perpetuate locating the position of the corner:**

The following new corner references:

- corner fence post N05°E 26.1 ft. (Fence running north)
- 8" R Pine (no nails & not blazed) N50°W 40.2 ft.
- 9" R Pine (no nails & not blazed) North 74.2 ft.
- 13" R Maple (blazed) S27°W 82.14 ft.

(NOTE: Corner is accepted as the best evidence of the perpetuated location of the original corner.)

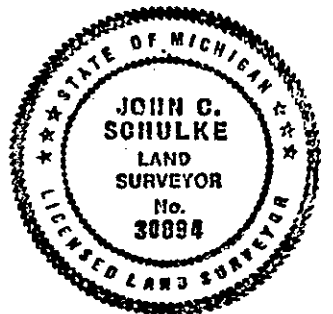

Signed by John C. Schulke

Date Oct 5, 1994

Surveyor's Michigan License No. RLS-30894

Peer Group Reviewed and Approved

Date: 10-5-94

Kenneth L. Ross  
Mason County Surveyor

Peer Group Reviewed and Approved  
FORM APPROVED BY MICHIGAN STATE BOARD OF LAND SURVEYORS, JAN. 28, 1971

Date: Feb 25, 1994

Kenneth L. Ross  
Mason County Surveyor