

MAR 16 1998

SECTION

LAND CORNER RECORDATION CERTIFICATE
Filing Requirement of Act 74, Mich. P.A. 1970

For corners in

| | | |
|---------------------------------------|---------------------------|----------------|
| <u>MASON</u> (County) | Located In: | Corner Code #/ |
| 1. Public Land Survey | T <u>18N</u> R <u>15W</u> | <u>G-7</u> |
| | T _____ R _____ | |
| | T _____ R _____ | <u>Seg. 2</u> |
| | T _____ R _____ | |
| 2. Property Controlling in Section | S _____ T _____ R _____ | |
| | S _____ T _____ R _____ | |
| 3. Miscellaneous Property in Sec. | S _____ T _____ R _____ | |
| | S _____ T _____ R _____ | |
| 4. Lot No. _____, Recorded Plat _____ | | |
| 5. Private Claims _____ | | |


FILED

AT 10:35 O'CLOCK a M.

OCT 13 1994

MARY GOLDEN KOLASKI
MASON COUNTY
REGISTER OF DEEDS

Register of Deeds Stamp & File Number

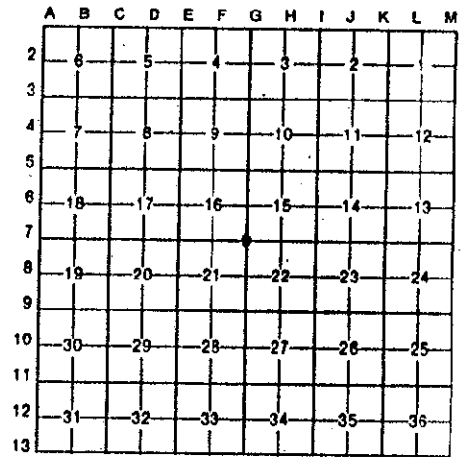

I, John Schulke, in a field survey on Aug. 30, 19 94, do hereby certify that under requirements of P.A. 74, Michigan P.A. of 1970, the corner points mentioned in lines 1 and 2 above were in conformance with regulations and rules therefore as required in the current manual of survey instructions of the United States Department of the Interior, Bureau of Land Management or by a decree of a Court of Law and/or that the corner points mentioned in lines 3, 4 and 5 above were in conformance with the rules of the Michigan Board of Land Surveyors or by a Decree of a Court of Law; established, re-established, monumented, re-monumented, recovered, found as expressed below:

NOTE: Not more than 4 corners, all in the same town and range, may be recorded on this certificate.

- A. Description of original monument and accessories and/or subsequent restoration:
- Original survey established in 1838 by Sibley. Set wooden post with the following corner references:
 - 1. 14" Pine N10°E 16 lks.
 - 2. 14" Beech S32°E 18 lks.
 - In 1902, R.O. Towns shows 3/4" iron with the following corner references:
 - 3. 18" Pine stump S35 1/2°W 54 lks.
 - 4. 14" Pine stump S46 1/2°E 24 lks.
 - In 1904, R.O. Towns surveyed Section 16 (see Book 2, pages 140 & 141). No references.
 - In 1920, MDOT survey the point-of-beginning (Approx. W 1/16th corner of Sections 15 & 22) East 1351.75 ft. The Southwest corner of Section 16 bears West 5325 ft.
 - In 1953, MDOT survey for U.S-10 found 1" axle shaft with the following list of corner references:
 - 5. 14" Oak S55°E 61.35 ft.
 - 6. 14" Oak S57°W 60.37 ft.
 - 7. 18" Oak N12°E 52.30 ft.

CONTINUE ON BACK

B. Description of corner evidence found and/or method applied in restoring or reestablishing corner:

Recovered Griffin's monument and the recovered the following corner references:

| | | | |
|-------------|-------------------------------|-------|------------|
| see #5 & 14 | 22" Blk. Oak | S48°E | 61.09 ft. |
| #15 | 10" W. Oak | N42°E | 88.51 ft. |
| #17 | 12" R Oak | S41°W | 113.83 ft. |
| #18 | Sq. post | South | 33.17 ft. |
| #19 | SE corner of cabin foundation | N18°W | 167.21 ft. |
| #10 | 18" Blk. Oak | N38°W | 74.29 ft. |

C. Description of monument for corner and accessories established to perpetuate locating the position of the corner:

Accepted Griffin's corner as the best evidence of the perpetuated location of the original corner. Placed a monument box over the monument with spike for riser. The following new corner references:

| | | | |
|--------------|-------|------------|-----------|
| Power Pole | N33°E | 38.73 ft. | |
| 10" W. Oak | N42°E | 88.51 ft. | (see #15) |
| 22" Blk. Oak | S55°E | 61.09 ft. | (see #14) |
| 12" R Oak | S41°W | 113.83 ft. | (see #17) |

Signed by John C Schulke Date Oct. 5, 1994

Surveyor's Michigan License No. PLS-30894

Peer Group Reviewed and Approved

FORM APPROVED BY MICHIGAN STATE BOARD OF LAND SURVEYORS, JAN. 28, 1971
REVISED MAY 14, 1975
REVISED JAN., 1983

Date: Oct 5, 1994
Kenneth L. Ross
Mason County Surveyor

Date: Feb 25, 1997
Kenneth L. Ross