

DEC 29 1998

LAND CORNER RECORDATION CERTIFICATE

Filing Requirement of Act 74, Mich. P.A. 1970

SECTION

For corners in

MASON

(County)

Located In:

Corner Code #

1. Public Land Survey

T 18N R 16W

A-9 ✓

T 18N R 17W

M-9

T R

T R

2. Property Controlling in Section

S T R

S T R

3. Miscellaneous Property in Sec.


S T R

S T R

4. Lot No. _____ Recorded Plat _____

5. Private Claims _____

FILED
10 O'CLOCK 22 A.M.

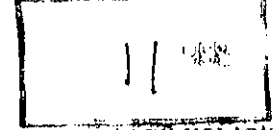

Register of Deeds Stamp & File Number

I, Kenneth L. Ross, in a field survey on July 23 1998, do hereby certify that under requirements of P.A. 74, Michigan P.A. of 1970, the corner points mentioned in lines 1 and 2 above were in conformance with regulations and rules therefore as required in the current manual of survey instructions of the United States Department of the Interior, Bureau of Land Management or by a decree of a Court of Law and/or that the corner points mentioned in lines 3, 4 and 5 above were in conformance with the rules of the Michigan Board of Land Surveyors or by a Decree of a Court of Law, established, re-established, monumented, re-monumented, recovered, found as expressed below:

NOTE: Not more than 4 corners, all in the same town and range, may be recorded on this certificate.

A. Description of original monument and accessories and/or subsequent restoration:

A-9 Section Corner for Sections 19 and 30, T18N-R16W & Sections 24 and 25, T18N-R17W.

1838, Mullett & Brookfield, G.L.O. boundary survey

Set Wood post

#1 Cedar 9" N 63 W 29 lks. (19.14')

#2 Black Ash 12" S 42 W 61 lks. (40.26')

1963, Ken Stephens, Mason Co. Surveyor

Established Corner at the intersection of Scottville & Conrads Roads, Set 3/4" Iron Pipe. (file no. E-47)

J. H. Jones, Mason Co. Survey no date

Identifies by old trees (Gov't wit.)

Set Post (book 1, pg 75)

1985, Ken Ross, RLS #17634 (file no. E-135, 97165s.)

Used 3/4" Iron in monument box, at the center-line of Scottville Road, Note this corner is 19.28 ft. West of an existing 3/4" iron in monument box, that as been used in other surveys.

3. Description of corner evidence found and/or method applied in restoring or reestablishing corner:

A-9 Section Corner for Sections 19 and 30, T18N-R16W & Sections 24 and 25, T18N-R17W.

On July 23, 1998, I found a 3/4" inside an road monument box, at the center-line of Scottville and Conrads Roads, I also found that the 3/4" iron and monument box 19.28' East of Stephens corner was removed, only a hole remains. I found no evidence to dispute this corner.

Condition of record witnesses are as follows; #1 Gone #2 Gone

Note: This corner is located at the center-line intersections of Scottville Road and Conrad Road.

Description of monument for corner and accessories established to perpetuate locating the position of the corner:

A-9 Section Corner for Sections 19 and 30, T18N-R16W & Sections 24 and 25, T18N-R17W.

I replaced 3/4" Iron Pipe, in the exact location, with a 5/8" re-rod, and an aluminum cap 3 1/2" in dia., stamped MASON COUNTY MONUMENT, place in existing monument box, encased in concrete. This corner is accepted as a careful and faithful re-establishment of the position of the original corner.

IT" #3 Cedar 8" S 55 W 55.58' (60d spike in SE side of tree)

IT" #4 Cedar 8" N 60 W 57.88' (60d spike in SW side of tree)


IT" #5 Cedar 10" N 51 E 77.80' (60d spike in SE side of tree)

.t. #6 "X" in SE corner of concrete Head wall for a 24" culvert S 50 E 54.90'

igned by [Signature]

Date Sept. 8, 1998 17634

urveyor's Michigan License No. 17634

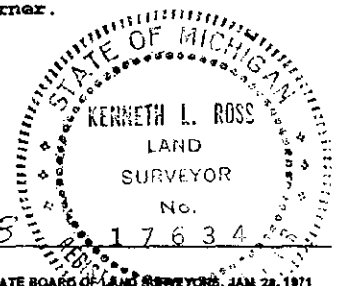

FORM APPROVED BY MICHIGAN STATE BOARD OF LAND SURVEYORS, JAN 29, 1971

REVISIO MAY 14, 1976
REVISED JAN. 1983
ADAPTED FOR WORD PROCESSING MARCH, 1993

Date: 9-8-98
[Signature]