

FEB 08 2000

SECTION

LAND CORNER RECORDATION CERTIFICATE

Filing Requirement of Act 74, Mich. P.A. 1970

For corners in MASON (County) Located In: _____ Corner Code # _____

1. Public Land Survey T 18N R 16W B-1
 T _____ R _____
 T _____ R _____
 T _____ R _____


2. Property Controlling in Section S _____ T _____ R _____
 S _____ T _____ R _____

3. Miscellaneous S _____ T _____ R _____

Property in Sec. S _____ T _____ R _____

4. Lot No. _____, Recorded Plat _____

5. Private Claims _____

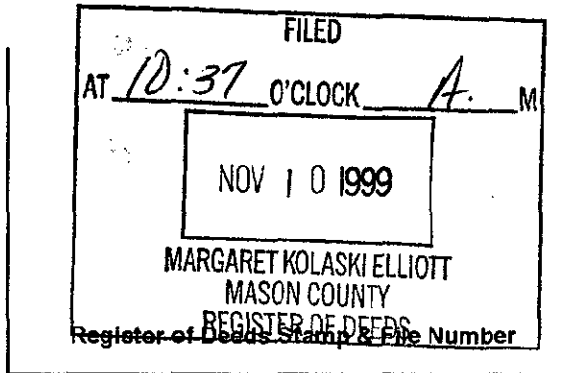

	A	B	C	D	E	F	G	H	I	J	K	L	M
1													
2	6	5	4	3	2	1							
3													
4	7	8	9	10	11	12							
5													
6	18	17	16	15	14	13							
7													
8	19	20	21	22	23	24							
9													
10	30	29	28	27	26	25							
11													
12	31	32	33	34	35	36							
13													

I, Kenneth L. Ross, in a field survey on August 28, 1999, do hereby certify that under requirements of P.A. 74, Michigan P.A. of 1970, the corner points mentioned in lines 1 and 2 above were in conformance with regulations and rules therefore as required in the current manual of survey instructions of the United States Department of the Interior, Bureau of Land Management or by a decree of a Court of Law and/or that the corner points mentioned in lines 3, 4 and 5 above were in conformance with the rules of the Michigan Board of Land Surveyors or by a Decree of a Court of Law; established, re-established, monumented, re-monumented, recovered, found as expressed below:

NOTE: Not more than 4 corners, all in the same town and range, may be recorded on this certificate.

A. Description of original monument and accessories and/or subsequent restoration:
 B-1, N 1.4 Corner Section 5, T.18N., R.16W.,

Corner not set by GLO

R.O. Towns, 1903, Book 2, page 96 and book 4, page 98, "Planted 1/4 post by propionate measurement." Does not state what was set, No Witnesses Given. Distance west to A-1, 2588.52' Distance East to C-1, 2642.64'

Kenneth L. Ross, Mortgage Survey May, 1984, States "Set 1/2" iron 45.25' East of B-13, T.19N., R.16W., Distance West to A-1, 2588.89' No new witnesses given.

Kenneth L. Ross, Act 132, Oct. 1990 States "existing 1/2" iron rod" 45.21' East of B-13, T.19N., R.16W., Distance West to A-1, 2588.87' Distance East to C-13, T.19N., R.16W 2604.88'


B. Description of corner evidence found and/or method applied in restoring or reestablishing corner:
 B-1, N 1.4 Corner Section 5, T.18N., R.16W.,

Found a 1/2" X 24" iron re-rod bent by road grading on the surface of Decker Road, 5' North of the South edge of gravel. I could find no other evidence to dispute the location of this corner.

C. Description of monument for corner and accessories established to perpetuate locating the position of the corner:
 B-1, N 1.4 Corner Section 5, T.18N., R.16W.,

I replaced the 1/2" X 24" iron re-rod in its exact location with a 5/8" X 24" iron re-rod with a standard 3" aluminum cap stamped "Mason County Monument", 1 foot below the gravel surface of Decker Road and accepted this corner as the best available evidence of the position of the corner.

- (1) B-13, T.19N., R.16W., iron/with 3" aluminum cap, "Stamped Mason County Monument", West, 45.21'
- (2) Set 60d spike next to underground electric PVC pipe, NE side of P.P., N50°W, 61.30'
- (3) Existing 60d spike, SE Side of Service Pole, S87°W, 148.42'
- (4) Center of 10" Red Maple (No spike set), N08°W, 68.50'
- (5) Center of 3" pipe for Basketball Backboard, N56°E, 96.35'

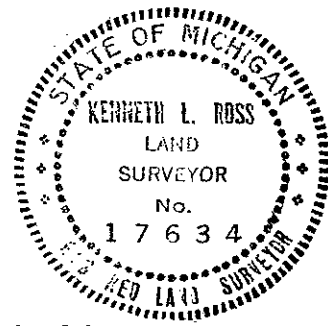

Signed by [Signature] Date Nov. 4, 1999
 Surveyor's Michigan License No. 17634