

DEC 29 1998

LAND CORNER RECORDATION CERTIFICATE

Filing Requirement of Act 74, Mich. P.A. 1970

SECTION


For corners in

MASON (County)

Located In:

Corner Code #

- 1. Public Land Survey T 18N R 16W B-9
2. Property Controlling in Section S T R
3. Miscellaneous Property in Sec. S T R

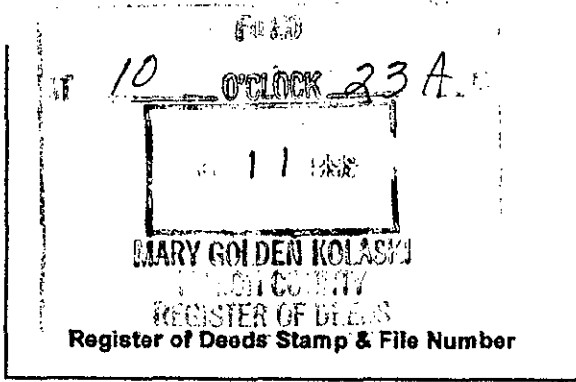

- 4. Lot No. Recorded Plat
5. Private Claims

I, Kenneth L. Ross, in a field survey on July 23, 1998, do hereby certify that under requirements of P.A. 74, Michigan P.A. of 1970, the corner points mentioned in lines 1 and 2 above were in conformance with regulations and rules therefore as required in the current manual of survey instructions of the United States Department of the Interior, Bureau of Land Management or by a decree of a Court of Law and/or that the corner points mentioned in lines 3, 4 and 5 above were in conformance with the rules of the Michigan Board of Land Surveyors or by a Decree of a Court of Law, established, re-established, monumented, re-monumented, recovered, found as expressed below.

NOTE: Not more than 4 corners, all in the same town and range, may be recorded on this certificate.

A. Description of original monument and accessories and/or subsequent restoration: B-9 1/4 Corner for Sections 19 and 30, T18N-R16W.

- 1838, Sylvester Sibley, G.L.O. Set Wood Post #1 Beech 14" N 47 E 34 lks. (22.44') #2 Sugar 10" S 20 W 12 lks (7.92')
1903, R. O. Towns, Mason Co. Surveyor Located by flat stone marked O. P. planted stone ? (book 1 page 100) Identifies as stone with "X" (book 1 pg. 75) no date, J. H. Jones, Mason Co. Surveyor Identifies as a stone with "X" mark (book 1 pg 75)
1987, Ken Ross, RLS #17634 (liber 2, page 288) Set 1/2" capped re-rod, established this position from Towns N-S 1/4 line, and Jones distance from NE Cor. ( Ross = 2757.48', Jones = 2757.00'), location also fits old fence lines North & South (file no. 89289s., 89205s.)
#3 Power-Pole S 40 W 49.67' #4 Re-rod 1/2" capped east 72.92' (corner as established by Kraft-Northwest Surveying in 1971)
1997, Rex Pope, RLS #39093 Used 1/2" Re-rod, with Ross RLS cap #5 Power Pole S 23 W 129.95' #6 Power Pole S 40 W 40.60' #7 Power Pole N 76 W 168.45' (file no. 97159 )

Table with 13 rows and 12 columns (A-L). Row 1: A-L. Row 2: 6, 5, 4, 3, 2, 1. Row 3: 7, 8, 9, 10, 11, 12. Row 4: 18, 17, 16, 15, 14, 13. Row 5: 19, 20, 21, 22, 23, 24. Row 6: 30, 29, 28, 27, 26, 25. Row 7: 31, 32, 33, 34, 35, 36.

B. Description of corner evidence found and/or method applied in restoring or reestablishing corner: B-9 1/4 Corner for Sections 19 and 30, T18N-R16W.

On July 23, 1998, I found re-rod set by me in previous survey, I found no evidence to dispute this location for the corner. Note: corner is 5.28' South of the center-line of Conrad Road. Note: Mason County Peer Review, determine that the Kraft-Northwest corner was set in error.

Condition of record witnesses are as follows: #1 Gone #2 Gone #3 Found in good condition #4 Found in good condition #5 Found in good condition #6 Found in good condition #7 Found in good condition


C. Description of monument for corner and accessories established to perpetuate locating the position of the corner: B-9 1/4 Corner for Sections 19 and 30, T18N-R16W.

I replaced, in the exact location, the 1/2" Re-rod with cap, with a Harrison cast iron monument (4" dia. top, 18 1/2" long) stamped MASON COUNTY MONUMENT, monument is set flush with the road surface and encased in concrete. This corner is accepted as a careful and faithful re-establishment of the position of the original corner.

- Ext "BP" #3 Power Pole S 40 W 49.67' (60d spike in SE side of tree)
Ext "wit. #4 1/2" re-rod yellow cap East 72.92'
New "BT" #8 Poplar 18" N 78 W 132.62' (16p nail in NE side of tree)
New wit. #9 & #10 1/2" re-rods with yellow RLS caps 33.00 feet North & 33.00 feet South.

Signed by [Signature] Date Sept. 8, 1998

Surveyor's Michigan License No. 17634

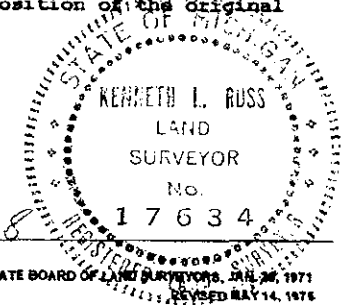

FORM APPROVED BY MICHIGAN STATE BOARD OF LAND SURVEYORS, JAN. 26, 1971 REVISION MAY 14, 1976 REVISED JAN. 1983 ADAPTED FOR WORD PROCESSING MARCH, 1993

Peer Group Reviewed and Approved 9-8-98 [Signature]