


FEB 08 2000

LAND CORNER RECORDATION CERTIFICATE

Filing Requirement of Act 74, Mich. P.A. 1970

SECTION

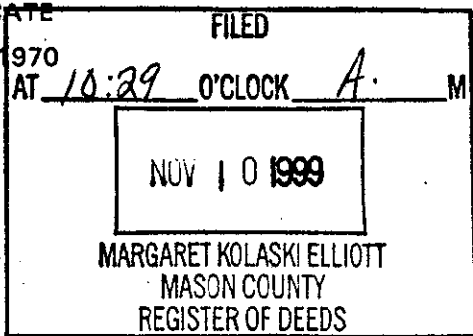

For corners in MASON (County) Located In: _____ Corner Code # _____

1. Public Land Survey T 18N R 16W C-1
 T _____ R _____
 T _____ R _____
 T _____ R _____

2. Property Controlling in Section S _____ T _____ R _____
 S _____ T _____ R _____

3. Miscellaneous S _____ T _____ R _____
 Property in Sec. S _____ T _____ R _____

4. Lot No. _____, Recorded Plat _____

5. Private Claims _____

Register of Deeds Stamp & File Number

I, Kenneth L. Ross, in a field survey on August 28, 1999, do hereby certify that under requirements of P.A. 74, Michigan P.A. of 1970, the corner points mentioned in lines 1 and 2 above were in conformance with regulations and rules therefore as required in the current manual of survey instructions of the United States Department of the Interior, Bureau of Land Management or by a decree of a Court of Law and/or that the corner points mentioned in lines 3, 4 and 5 above were in conformance with the rules of the Michigan Board of Land Surveyors or by a Decree of a Court of Law; established, re-established, monumented, re-monumented, recovered, found as expressed below:

NOTE: Not more than 4 corners, all in the same town and range, may be recorded on this certificate.

A. Description of original monument and accessories and/or subsequent restoration:
 C-1, Corner Common to Sections 5 and 6, T.18N., R.16W.,

GLO by Mullet and Brookfield 1837 (Twp Lines) "North bdry 58 links (38.28') east of post, set post Cor Sections 5 & 6"
 (1) Beech, 6", S 13°W, 8 links (5.28')
 (2) Beech, 14", S78°E, 10 links (6.60')

R.O. Towns, 1903, Book 4, page 98 Survey of Section 6, "Located Cor. by Stone/w/X" No Witnesses Given
 Distance West to B-1, 2642.64'
 Distance South to C-2, 2608.98'

J.A. Mitchell, 1880, Book 1, page 106 Survey of Section 5, "Identified Gover't. Marker, Trees standing" No new Witnesses
 Distance East to D-1, 2615.92'
 Distance South to C-2, 2600.40'

K.L. Ross, May, 1984, Tied this corner. No witnesses given. does not state what he found.
 Distance West to B-1, 2643.07'

R.O. Towns, 1903, Book 2, page 102 and Book 4, page 114, Survey of Section 5, "Stone with X" No Witnesses Given.
 Distance East to D-1, 2624.16'
 Distance South to C-2, 2613.60'

B. Description of corner evidence found and/or method applied in restoring or reestablishing corner:
 C-1, Corner Common to Sections 5 and 6, T.18N., R.16W.,

Found 4" X 24" re-rod, 2' South of the Center-line of Decker Road. I completed a search in the area for the stone as described by Towns above but could not locate. I could find no other evidence to dispute the location of this corner. Witnesses (1) and (2) above have been destroyed. There are some existing witnesses in the area, but I could not locate any information of record on these witnesses.

C. Description of monument for corner and accessories established to perpetuate locating the position of the corner:
 C-1, Corner Common to Sections 5 and 6, T.18N., R.16W.,


I replaced the 4" X 24" re-rod as described above, in the exact location with a Standard 3" Cast Iron Harrison Monument "Stamped Mason County Monument", 1.0 foot below the surface and 2' South of the Center-line of Decker Road. This corner accepted as the best available evidence of the re-establishment of the position of the original corner.

- (3) Corner C-13, T.19N., R.16W., Set 3" Harrison cast iron monument, West, 38.28'
- (4) Set 60d spike, SW Side, 36" Sugar Maple, S02°E, 28.06'
- (5) Center of 10" Locust (no spike set in yard), N54°W, 108.96'
- (6) Existing 60d spike, west side of P.P., N02°W, 45.70'
- (7) Set 60d spike, NW side 24" Sugar Maple, N64°E, 64.11'
- Center-line Darr Road to North, West 38.3'

Signed by Kenneth L. Ross

Date Nov. 4, 1999

Surveyor's Michigan License No. 17634

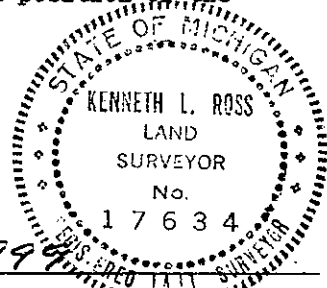

Peer Group Reviewed and Approved
 Date: 11-04-99
Kenneth L. Ross
 Mason County Surveyor

FORM APPROVED BY MICHIGAN STATE BOARD OF LAND SURVEYORS, JAN. 28, 1971
 REVISED MAY 14, 1975
 REVISED JAN., 1983
 ADAPTED FOR WORD PROCESSING MARCH, 1993