

**SURVEY & REMONUMENTATION**

MAR 16 1998

LIBER -- 4 PAGE 122

**LAND CORNER RECORDATION CERTIFICATE**

**SECTION**


Filing Requirement of Act 74, Mich. P.A. 1970

For corners in MASON (County) Located In: \_\_\_\_\_ Corner Code # \_\_\_\_\_

1. Public Land Survey T 18 NR 16 W C-13 ✓  
 T 17 NR 16 W C-1  
 T \_\_\_\_\_ R \_\_\_\_\_  
 T \_\_\_\_\_ R \_\_\_\_\_

2. Property Controlling in Section S \_\_\_\_\_ T \_\_\_\_\_ R \_\_\_\_\_  
 S \_\_\_\_\_ T \_\_\_\_\_ R \_\_\_\_\_

3. Miscellaneous Property in Sec. S \_\_\_\_\_ T \_\_\_\_\_ R \_\_\_\_\_  
 S \_\_\_\_\_ T \_\_\_\_\_ R \_\_\_\_\_

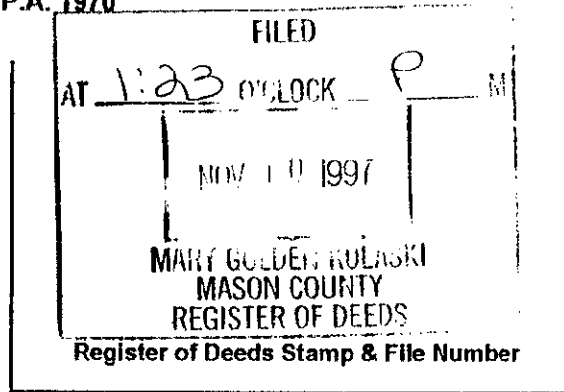

4. Lot No. \_\_\_\_\_, Recorded Plat \_\_\_\_\_  
 5. Private Claims \_\_\_\_\_

I, Sammy S. Barnett, in a field survey on Sept. 15th 19 97, do hereby certify that under requirements of P.A. 74, Michigan P.A. of 1970, the corner points mentioned in lines 1 and 2 above were in conformance with regulations and rules therefore as required in the current manual of survey instructions of the United States Department of the Interior, Bureau of Land Management or by a decree of a Court of Law and/or that the corner points mentioned in lines 3, 4 and 5 above were in conformance with the rules of the Michigan Board of Land Surveyors or by a Decree of a Court of Law; established, re-established, monumented, re-monumented, recovered, found as expressed below:

	A	B	C	D	E	F	G	H	I	J	K	L	M
2		6	5		4		3		2		1		
4		7	8		9		10		11		12		
6		18	17		16		15		14		13		
8		19	20		21		22		23		24		
10		30	29		28		27		26		25		
12		31	32		33		34		35		36		

NOTE: Not more than 4 corners, all in the same town and range, may be recorded on this certificate.

**A. Description of original monument and accessories and/or subsequent restoration:**

C - 13 Corner common to sections 31 & 32 T18N, R16W & C - 1 Corner common to sections 5 & 6 T17N R16W

1838 GLO survey by Mullett & Brookfields Set post  
 # 1 Beech 12" S10E 54 lks (35.64')  
 # 2 Sugar 8" S75W 45 lks (29.7')

1958 records at Mason County Road Comm.  
 Iron and stone  
 # 3 P.P. # 15A NW 81.7'  
 # 4 SW cor. Hall N54-30E 101.4'  
 # 5 Maple 12" N55-40E 95.6'  
 # 6 P.P. # 16 SE 53.4'

**B. Description of corner evidence found and/or method applied in restoring or reestablishing corner:**

C - 13 Corner common to sections 31 & 32 T18N, R16W & C - 1 Corner common to sections 5 & 6 T17N R16W

On Sept. 15th 1997, I found a railroad spike in the centerline of the east-west blacktop road and in the centerline of the north-south gravel roads, the condition of the witnesses is as follows,  
 # 1 Gone # 2 Gone # 3 Gone # 4 Gone # 5 Found 24" # 6 Gone


**C. Description of monument for corner and accessories established to perpetuate locating the position of the corner:**

C - 13 Corner common to sections 31 & 32 T18N, R16W & C - 1 corner common to sections 5 & 5 T17N R16W

On Sept 15th 1997 I replaced the railroad spike with a Standard Mason County Monument and accepted this location as the best available evidence of the position of the original corner, and took the following witnesses.

# 7 Guy pole N50E 56.25' existing 16d spike in SE side  
 # 8 Power pole # ENF 40 S48E 57.95' existing 16d spike in SE side  
 # 9 Centerline of telephone riser S51W 41.05'  
 # 10 Power pole N20W 79.55' existing bolt in NE side  
 # 11 Spruce 16" N20E 48.10' existing 16d set 60d spike SE side  
 # 12 Maple 24" N60E 96.41' set 60d spike in SE side (# 5)

2629.26' west to B 13, 2658.58' East to D 13  
 Corner fall in approximatley 3' of fill. Corner is in a monument box.

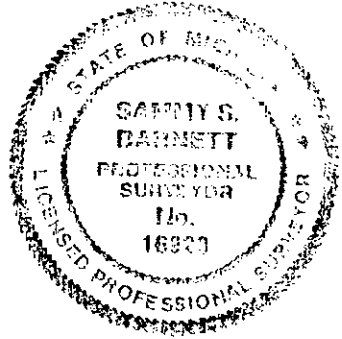

Signed by Sammy S. Barnett Date 11-4-97  
 Surveyor's Michigan License No. P S # 16923

Peer Group Reviewed and Approved  
 Date: Oct 2, 1997  
Kenneth L. Ross  
 Mason County Surveyor