

SURVEY & REMONUMENTATION

FEB 08 2000

LAND CORNER RECORDATION CERTIFICATE

Filing Requirement of Act 74, Mich. P.A. 1970

SECTION

For corners in MASON Located in: _____ Corner Code # _____
 (County)

1. Public Land Survey T 18N R 16W _____ D-1
 T _____ R _____
 T _____ R _____
 T _____ R _____

2. Property Controlling S _____ T _____ R _____
 in Section S _____ T _____ R _____

3. Miscellaneous S _____ T _____ R _____

Property in Sec. S _____ T _____ R _____

4. Lot No. _____, Recorded Plat _____

5. Private Claims _____

FILED

AT 10:30 O'CLOCK A. M

NOV 10 1999

MARGARET KOLASKI ELLIOTT
 MASON COUNTY
 REGISTER OF DEEDS

Register of Deeds Stamp & File Number

	A	B	C	D	E	F	G	H	I	J	K	L	M
1													
2	6	5	4	3	2	1							
3													
4	7	8	9	10	11	12							
5													
6	18	17	16	15	14	13							
7													
8	19	20	21	22	23	24							
9													
10	30	29	28	27	26	25							
11													
12	31	32	33	34	35	36							
13													

I, Kenneth L. Ross, in a field survey on August 28, 1999, do hereby certify that under requirements of P.A. 74, Michigan P.A. of 1970, the corner points mentioned in lines 1 and 2 above were in conformance with regulations and rules therefore as required in the current manual of survey instructions of the United States Department of the Interior, Bureau of Land Management or by a decree of a Court of Law and/or that the corner points mentioned in lines 3, 4 and 5 above were in conformance with the rules of the Michigan Board of Land Surveyors or by a Decree of a Court of Law; established, re-established, monumented, re-monumented, recovered, found as expressed below:

NOTE: Not more than 4 corners, all in the same town and range, may be recorded on this certificate.

A. Description of original monument and accessories and/or subsequent restoration:
 D-1, N ¼ Corner Section 5, T.18N., R.16W., Corner not set by GLO

J.A. Mitchell, 1880, Book 1, page 106
 Survey of Section 5, "Established by Measurement" Does not state what was set, no Witnesses given.
 Distance West to C-1, 2615.91'
 Distance East to E-1, 2615.91'

K.L. Ross, Drain Survey undated
 Tied this corner, No witnesses given.
 States computed location.
 I found no other recorded information for this corner.

R.O. Towns, 1903, Book 2, opage 102 and Book 4, page 114, Survey of Sec.5
 "Iron place by measurement" No new witnesses Given.
 Distance West to C-1, 2624.16'
 Distance East to E-1, 2624.16'
 Distance South to C1/4 Cor, 2599.08'


B. Description of corner evidence found and/or method applied in restoring or reestablishing corner:
 D-1, N ¼ Corner Section 5, T.18N., R.16W.,

I found ¼" X 24" rerod with cap # 17634, 2' South of the center-line of Decker Road and 34.15' West of Corner D-13, T.19N., R.16W.,. I searched the area, but, I could find no other evidence to dispute the location of this corner.

C. Description of monument for corner and accessories established to perpetuate locating the position of the corner:
 D-1, N ¼ Corner Section 5, T.18N., R.16W.,

I replaced the ¼" X 24" re-rod in the exact location with a Standard 3" Cast Iron Harrison Monument stamped "Mason County Monument" 1 foot below the surface of Decker Road and 2' South of the Center-line. This corner accepted as the best available evidence of the position of the corner.

(1) D-13, T.19N., R.16W., Set 3" Harrison Cast Iron Monument, West, 34.15'
 (2) Set 60d Spike West side of P.P., N27°W, 53.60'
 (3) Existing 60d spike East side of P.P. S49°W, 34.68'
 (4) distance East to E-1, 2625.46'
 (5) distance West to C-1, 2625.46'
 Field Line to South
 Center-line of Two Track Field Drive to South, 15 feet east
 Center-line of Two Track Field Drive to North, 25' West

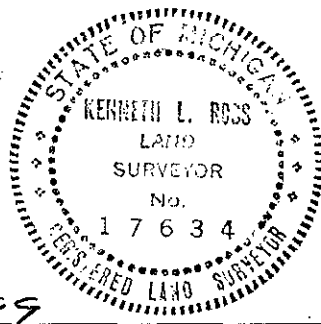

Signed by [Signature]
 Surveyor's Michigan License No. 17634

Date Nov. 4, 1999

Peer Group Reviewed and Approved
 Date: 11-24-99
[Signature]
 Kenneth L. Ross
 Mason County Surveyor