

DEC 3 9 1998

LAND CORNER RECORDATION CERTIFICATE

Filing Requirement of Act 74, Mich. P.A. 1970

For corners in SECTION
MASON (County)

Located In: Corner Code #

- 1. Public Land Survey T 18N R 16W D-5
- 2. Property Controlling in Section S T R
- 3. Miscellaneous Property in Sec. S T R

FILED
AT 10 O'CLOCK 20 A.M.
11
Register of Deeds Stamp & File Number

4. Lot No. _____, Recorded Plat _____
5. Private Claims _____

I, Kenneth L. Ross, in a field survey on May 29 19 98, do hereby certify that under requirements of P.A. 74, Michigan P.A. of 1970, the corner points mentioned in lines 1 and 2 above were in conformance with regulations and rules therefore as required in the current manual of survey instructions of the United States Department of the Interior, Bureau of Land Management or by a decree of a Court of Law and/or that the corner points mentioned in lines 3, 4 and 5 above were in conformance with the rules of the Michigan Board of Land Surveyors or by a Decree of a Court of Law, established, re-established, monumented, re-monumented, recovered, found as expressed below.

NOTE: Not more than 4 corners, all in the same town and range, may be recorded on this certificate.

A. Description of original monument and accessories and/or subsequent restoration:

D-5 1/4 Corner for Sections 8 & 17, T18N-R16W

- 1838, Sylvester Sibley, G.L.O.
Set Wood Post
#1 Cedar 10" S 60 E 8 lks. (5.28')
- #2 Black Ash 16" N 14 W 17 lks. (11.22')
- 1886, W. E. Matcalf, Dep. Co. Surveyor
States gov't witness trees are OK
Gives a distance of 39.46 chs. (2604.36') to the SE cor. & 39.70 chs. (2620.02') to the SW cor. (book 1 page 181)
- 1891, H. J. Johnson, Mason Co. Surveyor
Fallen gov't witness tree (fallen), Placed corner from fallen tree, (monument not given), gives a distance of 39.56 chs. (2610.96') to the SE cor. & 39.72 chs. (2621.52') to the SW cor. (book 1. pg 247)
- #3 Soft Maple 24" S 21 W 15 lks. (9.90')
- #4 Black Ash 8" N 00-30' W 36 lks. (23.76')

1919, C. E. Mitchell, Mason Co. Surveyor
Found Cedar stake, Gives a distance of 39.71 chs. (2620.86') to the SE cor. & 40.06 chs. (2643.96') to the SW cor. Sec. 8 (book 2, page 241)

1997, Ken Ross, RLS #17634, Mason Co. Surveyor
During cadastral survey of section 8, I search for monuments or markers and witness trees to identify this corner, but I found no evidence, except a very old fence cor. Used fence corner as best available evidence for the corner location. Measured a distance of 2622.46' to the SE cor. & 2639.07' to the SW cor. Set a 5/8" re-rod 24" long, 1.0 foot N 45 E, of old fence post. (file no. 97255s.)
#5 Maple 22" S 20 E 49.81'
#6 Twin Maple 10" 16" N 87 E 10.75'
#7 Elm 6" N 17 E 20.05'

	A	B	C	D	E	F	G	H	I	J	K	L	M
2	6	5	4	3	2	1							
3													
4	7	8	9	10	11	12							
5													
6	18	17	16	15	14	13							
7													
8	19	20	21	22	23	24							
9													
10	30	29	28	27	26	25							
11													
12	31	32	33	34	35	36							
13													

B. Description of corner evidence found and/or method applied in restoring or reestablishing corner:

D-5 1/4 Corner for Sections 8 & 17, T18N-R16W

On May 29, 1998, I found a 5/8" re-rod set by me in previous survey. I found no new evidence to dispute this location for the corner.

- Condition of record witnesses are as follows; #1 Gone #2 Gone #3 Gone #4 Gone
#5 Found in good condition #6 Found in good condition #7 Found in good condition

C. Description of monument for corner and accessories established to perpetuate locating the position of the corner:

D-5 1/4 Corner for Sections 8 & 17, T18N-R16W


I accepted 5/8" re-rod as a substantial marker for the corner, but I placed a 3" aluminum cap, stamped MASON COUNTY MONUMENT, over the top of iron. This corner is accepted as a careful and faithful re-establishment of the position of the original corner.

- Ext. "BT" #5 Maple 22" S 20 E 49.81' (60d spike in NE side of tree)
- Ext. "BT" #6 Twin Maple 10" - 16" 10.75' (60d spike in North side of tree)
- Ext. "BT" #7 Elm 6" N 17 E 20.05' (60d spike in SE side of tree)
- Ext. "BT" #8 Elm 10" S 86 W 8.84' (60d spike in North side of tree)

Signed by Kenneth L. Ross

Date Sept. 8, 1998

Surveyor's Michigan License No. 17634

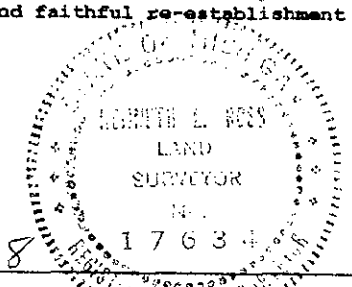

FORM APPROVED BY MICHIGAN STATE BOARD OF LAND SURVEYORS; JAN. 28, 1971
REVISED MAY 14, 1975
REVISED JAN. 1983

ADAPTED FOR WORD PROCESSING MARCH, 1993
Peer Group Reviewed and Approved

Date 9-8-98
Kenneth L. Ross