

DEC 29 1998

LAND CORNER RECORDATION CERTIFICATE

Filing Requirement of Act 74, Mich. P.A. 1970


For corners in SECTION Located In: Corner Code #

MASON (County)

1. Public Land Survey T 18N R 16W D-9
 T R
 T R
 T R

2. Property Controlling S T R
 in Section S T R

3. Miscellaneous S T R
 Property in Sec. S T R

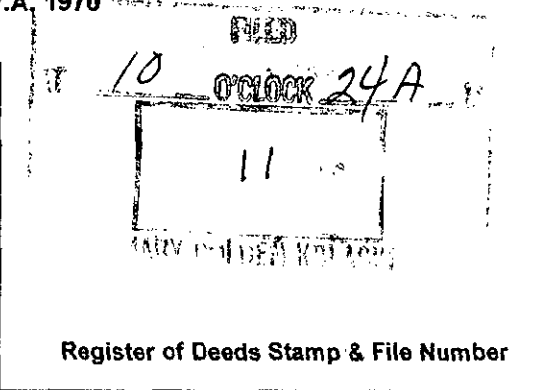

4. Lot No. _____, Recorded Plat _____

5. Private Claims _____

	A	B	C	D	E	F	G	H	I	J	K	L	M
1													
2	6	5	4	3	2	1							
3													
4	7	8	9	10	11	12							
5													
6	18	17	16	15	14	13							
7													
8	19	20	21	22	23	24							
9													
10	30	29	28	27	26	25							
11													
12	31	32	33	34	35	36							
13													

I, Kenneth L. Ross, in a field survey on July 23, 1998, do hereby certify that under requirements of P.A. 74, Michigan P.A. of 1970, the corner points mentioned in lines 1 and 2 above were in conformance with regulations and rules therefore as required in the current manual of survey instructions of the United States Department of the Interior, Bureau of Land Management or by a decree of a Court of Law and/or that the corner points mentioned in lines 3, 4 and 5 above were in conformance with the rules of the Michigan Board of Land Surveyors or by a Decree of a Court of Law, established, re-established, monumented, re-monumented, recovered, found as expressed below:

NOTE: Not more than 4 corners, all in the same town and range, may be recorded on this certificate.

A. Description of original monument and accessories and/or subsequent restoration:
 D-9 1/4 Corner for Sections 20 and 21, T18N-R16W.

- 1838, Sylvester Sibley, G.L.O.
Set Wood Post
- #1 Sugar Maple 14" N 69 E 18 lks. (11.88')
- #2 Sugar Maple 6" S 37 W 12 lks. (7.92')
- 1899, R.O. Towns, Mason co. surveyor
Identifies corner as a 3/4" pipe
(book 2, page 91)
- J. H. Jones, no date, identifies by old trees
(book 1, page 75)

- 1955, Ken Stephens, Mason Co. Surveyor (file no. E-021)
Found existing 3/4" pipe
- 1970, J. Borsfay, Mason Co. Road Comm. (Land Corner Record)
Found 1" Iron pipe, and wooden stake
- #3 Beech 30" NW 69.20'
- #4 Maple 18" SW 44.86'
- #5 Power Pole SW 95.18'
- #6 Fence corner post South 37.76'
(note: in 1973 Borsfay place iron in monument box)
- Ken Ross, RLS # 17634, used 3/4" Iron in Surveys (file no. E-71, 97315a, 96303a.)

B. Description of corner evidence found and/or method applied in restoring or reestablishing corner:
 D-9 1/4 Corner for Sections 20 and 21, T18N-R16W.

On July 23, 1998, I found 3/4" iron rod inside an existing monument box, in the center-line of Conrad Road, this location fit record witness that I recovered, I found no evidence to dispute this location for the corner.

Condition of record witnesses are as follows: #1 Gone #2 Gone #3 Found in good condition
 #4 Found stump #5 Found in good condition #6 Found post lying down

C. Description of monument for corner and accessories established to perpetuate locating the position of the corner:
 D-9 1/4 Corner for Sections 20 and 21, T18N-R16W.


I placed a 3 1/2" Aluminum Cap over existing Iron Rod, Stamped MASON COUNTY MONUMENT, I set Cap flush with the road surface, then encased it in concrete. This corner is accepted as a careful and faithful perpetuation of the position of the original corner.

- xt. "BT" #3 Beech 36" N 58 W 70.45' (set 60d spike in NE side of tree)
- xt. "BT" #5 Power Pole S 55 W 95.20' (Tag & nail in SE side of pole)
- aw "BT" #5 Poplar 5" S 47 E 46.05' (60d spike in SW side of tree)
- aw "BT" #7 Maple 26" S 68 W 70.40' (60d spike in NW side of tree)

Signed by Kenneth L. Ross

Date Sept. 8, 1998

Surveyor's Michigan License No. 17634

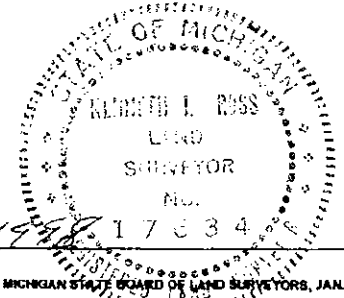

FORM APPROVED BY MICHIGAN STATE BOARD OF LAND SURVEYORS, JAN. 28, 1971
 REVISED MAY 14, 1975
 REVISED JAN. 1983
 ADAPTED FOR WORD PROCESSING MARCH, 1993

9-8-98
[Signature]