


FEB 08 2000

LAND CORNER RECORDATION CERTIFICATE

SECTION

Filing Requirement of Act 74, Mich. P.A. 1970

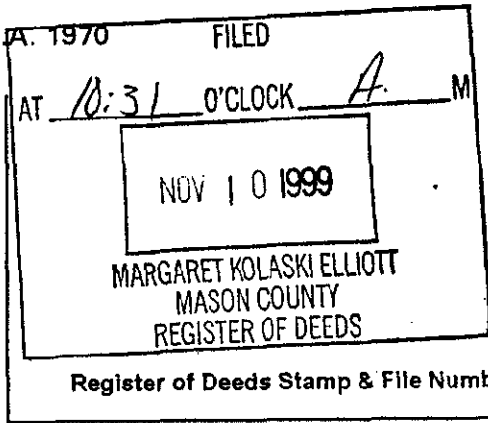

Form for recording corners. Includes fields for 'For corners in MASON (County)', 'Located in:', 'Corner Code #', and numbered sections 1-5 for describing the survey and property.

Grid table with columns A-M and rows 1-13. Contains numerical data points for corner locations.

I, Kenneth L. Ross, in a field survey on August 28, 1999, do hereby certify that under requirements of P.A. 74, Michigan P.A. of 1970, the corner points mentioned in lines 1 and 2 above were in conformance with regulations and rules therefore as required in the current manual of survey instructions of the United States Department of the Interior, Bureau of Land Management or by a decree of a Court of Law and/or that the corner points mentioned in lines 3, 4 and 5 above were in conformance with the rules of the Michigan Board of Land Surveyors or by a Decree of a Court of Law; established, re-established, monumented, re-monumented, recovered, found as expressed below:

NOTE: Not more than 4 corners, all in the same town and range, may be recorded on this certificate.

A. Description of original monument and accessories and/or subsequent restoration: E-1, Corner Common to Sections 4 and 5, T.18N., R.16W.,

GLO by Mullet and Brookfield 1837 (Twp. Lines) "North bdr'y 46 links (30.36') east of post, set post to sec 4 & 5 (1) Beech, 14", S64°E, 30 links (19.80') (2) Beech, 8", S13°W, 16 links (10.56')

W.E. Metcalf, 1887 & 1889, Book 1, page 183, Survey of Sec. 4, "Stake by C.E. Mitchell, stumps still visible" No new witnesses given. Distance East to F-1, 2632.41' Distance South to E-2, 2567.73'

K.L. Ross, Jan. 1984, Ex. Iron, 30.00' East of E-13, T.19N., R.16W., No witnesses given

J.A. Mitchell, 1876, Book 1, page 67 Survey of Sec. 4, does not state what he found or set. No Witnesses Given. Distance East to F-1, 2632.41' Distance South to E-2, 2567.73'

R.O. Towns, 1903, Book 2, page 107 and Book 4, page 114, Survey of Sec. 5, "Stone w/X" No Witnesses given. Distance West to D-1, 2614.92' Distance South to E-2, 2567.73'

K.L. Ross, May, 1984, Ex. Iron 30.00' East of E-13, T.19N., R.16W., No Wit. Given.

J.A. Mitchell, 1880, Book 1, page 106 Survey of Sec. 5, "Identified, Witnesses Trees standing" No new witnesses given. Distance West to D-1, 2614.92' Distance South to E-2, 2567.73'

R.O. Towns, 1903, Book 2, page 67 Survey of Sec. 4, "Stone w/X" No Witnesses Given. Distance East to F-1, 2638.02' Distance South to E-2, 2575.65'

K.L. Ross, Undated Drain Survey Tied this corner. 30.00' East of Corner E-13, T.19N., R.16W., No Witnesses Given

B. Description of corner evidence found and/or method applied in restoring or reestablishing corner: E-1, Corner Common to Sections 4 and 5, T.18N., R.16W.,

Found two 5/8" X 12" re-rod close together on North Side of Large Stone (as described by Towns above) I could not visibly find an x on the stone, but stone is pointed at the top. I could find no other evidence to dispute the location of this corner. Witnesses (1) and (2) above have been destroyed. There are existing witnesses in the area but, I could not locate any recorded information on them.

C. Description of monument for corner and accessories established to perpetuate locating the position of the corner: E-1, Corner Common to Sections 4 and 5, T.18N., R.16W.,

I replaced in the center of the two 5/8" X 12" re-rods in their exact location with a 5/8" X 24" iron re-rod with a standard 3" aluminum cap stamped "Mason County Monument", 1 foot below the gravel surface on the center-line of Decker and Tuttle Roads and accepted this corner as the best available evidence of the re-establishment of the Original Corner.

- (3) Corner E-13, T.19N., R.16W., Set 5/8" X 24" re-rod with Standard 3" Aluminum Cap, West, 29.95' (4) Existing 60d spike, east side, 30" White Pine, S29°W, 58.24' (5) existing 60d spike NW side P.P. N 49°E, 46.71' (6) Center of 2" dia Street Sign Post, N48°W, 48.67' (7) Existing 60d spike North side 15" Jack Pine, S80°W, 117.28'



Signed by [Signature] Surveyor's Michigan License No. 17634

Date Nov. 4, 1999

Peer Group Reviewed and Approved Date: 11-04-99 Kenneth L. Ross Mason County Surveyor

LIBER

4 PAGE 286