

FEB 08 2000

LAND CORNER RECORDATION CERTIFICATE

SECTION

Filing Requirement of Act 74, Mich. P.A. 1970

For corners in


MASON
(County)

Located in:

Corner Code #

- 1. Public Land Survey T 18N R 16W E-8
T R
T R
T R
- 2. Property Controlling in Section S T R
S T R
- 3. Miscellaneous Property in Sec. S T R
S T R

- 4. Lot No. _____, Recorded Plat _____
- 5. Private Claims _____

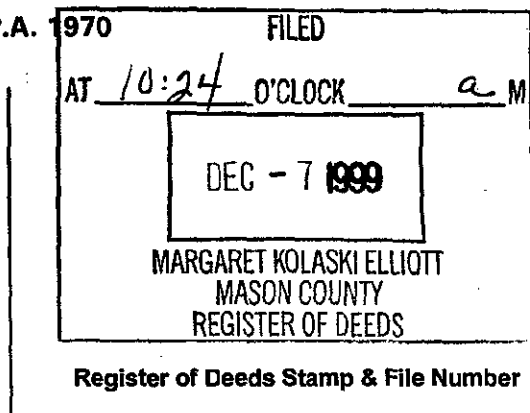

I, Rex E. Pope, in a field survey on December 19 98, do hereby certify that under requirements of P.A. 74, Michigan P.A. of 1970, the corner points mentioned in lines 1 and 2 above were in conformance with regulations and rules therefore as required in the current manual of survey instructions of the United States Department of the Interior, Bureau of Land Management or by a decree of a Court of Law and/or that the corner points mentioned in lines 3, 4 and 5 above were in conformance with the rules of the Michigan Board of Land Surveyors or by a Decree of a Court of Law; established, re-established, monumented, re-monumented, recovered, found as expressed below:

NOTE: Not more than 4 corners, all in the same town and range, may be recorded on this certificate.

A. Description of original monument and accessories and/or subsequent restoration:
E-8 1/4 corner between Sections 20 and 21, T18N-R16W

1838, Sylvester Sibley, G.L.O.
Black Ash 8" for the corner

#1 South Bank Pere Marquette River South 628.32 ft.

1880, James H. Jones, Mason County Surveyor
Post not found, re-set (monument not given)
Book 1, Page 161

1996, Kenneth Ross, RLS#17634

Set 5/8" Re-rod, at a single proportional distance, and on a straight line between controlling corners E-9 and E-7.

- #2 Maple 21" S60W 47.06'
- #3 Maple 17" N45W 60.03'
- #4 Maple 16" N62E 31.36'
- #5 Black Ash 15" S07E 24.26'

B. Description of corner evidence found and/or method applied in restoring or reestablishing corner:
E-8 1/4 corner between Sections 20 and 21, T18N-R16W

In December, 1998, I performed a retracement of the South Half of the East line of Section 20, T18N-R16W, Custer Township, Mason County. I located an old fence line (mostly down) along this line, and located it at approximately 100 foot intervals, from the Pere Marquette River, South to the Section corner. I then performed a best fit for these points. The line began 1 foot West of the fence at the Pere Marquette River and when projected South, ended up 2.7 feet West of the Southeast corner of Section 20, (E-9). I then extended this line North, over the Pere Marquette River, to a point which is equal distances from the Northeast corner of Section 20 (E-7), and the Southeast corner of Section 20 (E-9).

	A	B	C	D	E	F	G	H	I	J	K	L	M
2	6	5	4	3	2	1							
3													
4	7	8	9	10	11	12							
5													
6	18	17	16	15	14	13							
7													
8	19	20	21	22	23	24							
9													
10	30	29	28	27	26	25							
11													
12	31	32	33	34	35	36							
13													

C. Description of monument for corner and accessories established to perpetuate locating the position of the corner:
E-8 1/4 corner between Sections 20 and 21, T18N-R16W

I removed the 5/8" x 48" Rebar and placed in its exact location a 5/8" x 48" re-bar with a 3" standard aluminum cap stamped Mason County Monument and accepted this as the best available evidence of the re-establishment of the position of the original corner.

- #6 N43°W 33.16' 60d Spike in the NE face of 16" Sycamore
- #7 N44°E 31.05' 60d Spike in the S. face of 8" Elm
- #8 S70°W 31.36' 60d Spike in the SE face of 12" Basswood
- #9 S71°E 22.31' 60d Spike in the SW face of 10" Ash

Signed by

Date

7/12/99

Surveyor's Michigan License No.

39093

Date:

July 22, 1999
Kenneth L. Ross
Mason County Surveyor