


DEC 9 1998

LAND CORNER RECORDATION CERTIFICATE

Filing Requirement of Act 74, Mich. P.A. 1970

For corners in MASON (County) Located In: Corner Code #
1. Public Land Survey T 18N R 16W E-7
2. Property Controlling In Section S T R
3. Miscellaneous Property in Sec. S T R

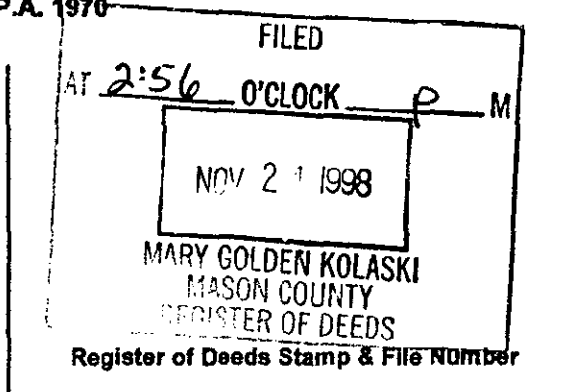

4. Lot No. Recorded Plat
5. Private Claims

I, Kenneth L. Ross, in a field survey on July 17 19 98, do hereby certify that under requirements of P.A. 74, Michigan P.A. of 1970, the corner points mentioned in lines 1 and 2 above were in conformance with regulations and rules therefore as required in the current manual of survey instructions of the United States Department of the Interior, Bureau of Land Management or by a decree of a Court of Law and/or that the corner points mentioned in lines 3, 4 and 5 above were in conformance with the rules of the Michigan Board of Land Surveyors or by a Decree of a Court of Law; established, re-established, monumented, re-monumented, recovered, found as expressed below.

Grid table with columns A-M and rows 1-13. Contains numbers 6-36 and a central dot at row 7, column D.

NOTE: Not more than 4 corners, all in the same town and range, may be recorded on this certificate.

A. Description of original monument and accessories and/or subsequent restoration: E-7 Section Corner for Sections 16, 17, 20 and 21, T18N-R16W.

- 1839, Sylvester Sibley, G.L.O. Set Wood Post #1 Sugar 12" N 30 W 31 lks. (20.45') #2 Beech 12" S 53 E 6 lks. (3.96')
1880, James H. Jones, Dep. Survey (Liber 1 Page 161) Identified Stake, replace with gas pipe #6 Elm 6" S 54-30 W 97 lks. (64.02')
1919, C. E. Mitchell, Mason Co. Surveyor (book 2, Pg. 247) Found Stone for corner, no witnesses given
1956, Mason Co. Road Comm. 3/4" Iron Pipe, Stone, old saw blade #3 Elm 14" NE 64.3' #4 Fence Corner Post SE 32.0' #5 Boulder SW 67.70' (Land Corner Card)
1985, Ken Ross, RLS# 17634 Found 1/2" iron in surveys E-143, 24891s. and 96398s. #7 Red Pine 8" S 20 E 48.42' #8 Black Ash 10" N 03 W 175.73' #9 Red Pine 10" S 42 W 53.71'

B. Description of corner evidence found and/or method applied in restoring or reestablishing corner: E-7 Section Corner for Sections 16, 17, 20 and 21, T18N-R16W.


On July 17, 1998, I found a 1/2" Iron Pipe along side a stone, one foot North of the center-line of First Street. I found no evidence to dispute this location for the corner.

- Condition of record witnesses are as follows; #1 Gone #2 Gone #3 Gone #4 Gone #5 Found hole were boulder might have been #6 Gone #7 Found in good condition #8 Found in good condition #9 Found in good condition

C. Description of monument for corner and accessories established to perpetuate locating the position of the corner: E-7 Section Corner for Sections 16, 17, 20 and 21, T18N-R16W.

I replaced 1/2" Iron Pipe, in the exact location, with a Harrison cast iron monument (4" top, 18 1/2" long), stamped MASON COUNTY MONUMENT, I set monument 1/2 foot below gravel road, encased in concrete. This corner is accepted as a careful and faithful re-establishment of the position of the original corner.

- Ext"BT"#6 Red Pine 9" S 20 E 48.42' (60d spike in SW side of tree)
Ext"BT"#7 Black Ash 13" N 03 W 175.73' (60d spike in East side of tree)
Ext"BT"#9 Red Pine 10" S 42 W 53.71' (60d spike in SE side of tree)
#10 Poplar 7" N 57 W 66.40' (16p nail in SW side of tree)

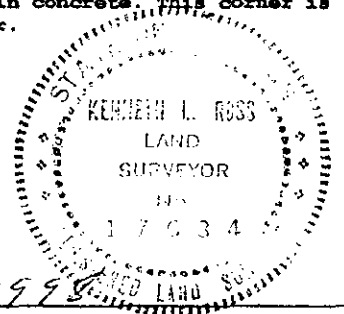

Signed by [Signature] Date Nov 19, 1998
Surveyor's Michigan License No. 17634

Peer Group Reviewed and Approved
Date: 10-21-98
Kenneth L. Ross
Mason County Surveyor