

SURVEY & REMONUMENTATION

MAR 16 1998

LAND CORNER RECORDATION CERTIFICATE

Filing Requirement of Act 74, Mich. P.A. 1970

SECTION

For corners in

MASON

(County)

Located In:

Corner Code #

FILED

2:51

LOCK

P M

1997

MISS BOLDEN KULASKI
MASON COUNTY
REGISTER OF DEEDS

Register of Deeds Stamp & File Number

- 1. Public Land Survey T 18N R 16W E-8
- 2. Property Controlling in Section S T R
- 3. Miscellaneous Property in Sec. S T R

- 4. Lot No. _____ Recorded Plat _____
- 5. Private Claims _____

I, Kenneth L. Ross, in a field survey on October 8, 1997, do hereby certify that under requirements of P.A. 74, Michigan P.A. of 1970, the corner points mentioned in lines 1 and 2 above were in conformance with regulations and rules therefore as required in the current manual of survey instructions of the United States Department of the Interior, Bureau of Land Management or by a decree of a Court of Law and/or that the corner points mentioned in lines 3, 4 and 5 above were in conformance with the rules of the Michigan Board of Land Surveyors or by a Decree of a Court of Law; established, re-established, monumented, re-monumented, recovered, found as expressed below.

NOTE: Not more than 4 corners, all in the same town and range, may be recorded on this certificate.

A. Description of original monument and accessories and/or subsequent restoration:

E-8 1/4 Corner for Section 20 and 21, T18N-R16W.
1838, Sylvester Sibley, G.L.O.
Black Ash 8" for the corner.
#1 South Bank Pere Marquette River South 628.32 ft.

1996, Kenneth Ross, RLS# 17634
Set 5/8" Re-rod, at a single proportional distance, and on a straight line between controlling corners E-9 and E-7.
#2 Maple 21" S 60° W 47.06 ft.
#3 Maple 17" N 45° W 60.03 ft.
#4 Maple 16" N 62° E 31.36 ft.
#5 Black Ash 15" S 07° E 24.26 ft.

	A	B	C	D	E	F	G	H	I	J	K	L	M
1													
2	6	5	4	3	2	1							
3													
4	7	8	9	10	11	12							
5													
6	18	17	16	15	14	13							
7													
8	19	20	21	22	23	24							
9													
10	30	29	28	27	26	25							
11													
12	31	32	33	34	35	36							
13													

1880, James H. Jones, Mason County Surveyor
Post not found re-set (monument not given)
Book 1 Page 161

B. Description of corner evidence found and/or method applied in restoring or reestablishing corner:

E-8 1/4 Corner for Section 20 and 21, T18N-R16W.
On October 8, 1997, I Ken Ross, Kevin Pritchard (survey tech.) and Eric Roberts (survey tech.), searched intensely for some evidence of any existing corner, historical or otherwise, with no success, so I accepted my single proportional distance position, as the evidence for this corner location.
Note: this area is very wet and prone to flooding.


Condition of recorded witnesses are: #1 Measured 620 + - #2 Found in good condition #3 Found in good condition #4 Found in good condition #5 Found in good condition

Date: Nov. 4, 1997
Kenneth L. Ross
Mason County Surveyor

C. Description of monument for corner and accessories established to perpetuate locating the position of the corner:

E-8 1/4 Corner for Section 20 and 21, T18N-R16W.
I set a 2 1/2 " aluminum cap, stamped to identify the corner, on top of existing 5/8" Re-Rod, 24" long, (a Mason County Monument), set 0.50 feet above the ground, and is accepted as a faithful and careful re-establishment of the position of the original corner.

- Ext "BT" #2 Maple 21" S 60° W 47.06 ft. (60d spike in SE side of tree)
- Ext "BT" #3 Maple 17" N 45° W 60.03 ft. (60d spike in SE side of tree)
- Ext "BT" #4 Maple 16" N 62° E 31.36 ft. (60d spike in NW side of tree)
- Ext "BT" #5 Black Ash 15" S 07° E 24.26 ft. (60d spike in NE side of tree)

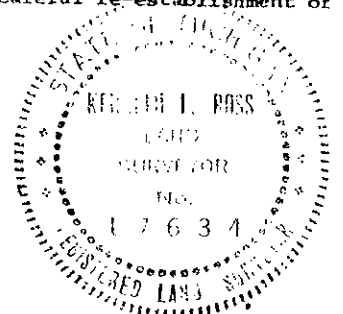

signed by Kenneth L. Ross Date Nov. 4, 1997
Surveyor's Michigan License No. 17634