

FEB 08 2000

LAND CORNER RECORDATION CERTIFICATE

Filing Requirement of Act 74, Mich P.A. 1970

FILED

AT 10:32 O'CLOCK A. M

NOV 10 1999

MARGARET KOLASKI ELLIOTT
MASON COUNTY
REGISTER OF DEEDS

Register of Deeds Stamp & File Number

SECTION

For corners in MASON (County)

Located In: _____ Corner Code # _____

1. Public Land Survey T 18N R 16W F-1

2. Property Controlling in Section S _____ T _____ R _____

3. Miscellaneous S _____ T _____ R _____

Property in Sec. S _____ T _____ R _____

4. Lot No. _____, Recorded Plat _____

5. Private Claims _____

	A	B	C	D	E	F	G	H	I	J	K	L	M
1													
2	6	5	4	3	2	1							
3													
4	7	8	9	10	11	12							
5													
6	18	17	16	15	14	13							
7													
8	19	20	21	22	23	24							
9													
10	30	29	28	27	26	25							
11													
12	31	32	33	34	35	36							
13													

I, Kenneth L. Ross, in a field survey on September 4, 1999, do hereby certify that under requirements of P.A. 74, Michigan P.A. of 1970, the corner points mentioned in lines 1 and 2 above were in conformance with regulations and rules therefore as required in the current manual of survey instructions of the United States Department of the Interior, Bureau of Land Management or by a decree of a Court of Law and/or that the corner points mentioned in lines 3, 4 and 5 above were in conformance with the rules of the Michigan Board of Land Surveyors or by a Decree of a Court of Law; established, re-established, monumented, re-monumented, recovered, found as expressed below:

NOTE: Not more than 4 corners, all in the same town and range, may be recorded on this certificate.

A. Description of original monument and accessories and/or subsequent restoration:
F-1, N ¼ Corner Section 4, T.18N., R.16W., Corner not set by GLO

J.A. Mitchell, 1876, Book 1, page 67
Does not state what he set or found
No Witnesses Given.
Distance West to E-1, 2632.41'
Distance East to G-1, 2632.41'

C.E. Mitchell, 1916, Book 2, pg. 67
"1" bolt, 15" long" No Witnesses given.
Distance West to E-1, 2638.02'
Distance East to G-1, 2638.02'

W.E. Metcalf, 1887 & 1889, Book 1, page 183
Survey of Sec. 4, "Gov't Witnesses down" F-13
T.19N., R.16W. 0.33 chains (21.78') East" rest of notes unreadable.
Distance West to E-1, 2632.41'
Distance East to G-1, 2632.41'
Distance South to C ¼ Cor, 2558.16'

In my research for this corner I found no other surveys that tied this corner.


B. Description of corner evidence found and/or method applied in restoring or reestablishing corner:
F-1, N ¼ Corner Section 4, T.18N., R.16W.,

I found the 1" X 15" Bolt as described by C.E. Mitchell above, 25.54' East of Corner F-13, T.19N., R.16W., I could find no other evidence to dispute the location of this corner. There are some existing witnesses in the area of this corner, but, in my research I did not find any recorded information for these witnesses.

C. Description of monument for corner and accessories established to perpetuate locating the position of the corner:
F-1, N ¼ Corner Section 4, T.18N., R.16W.,

I replaced the 1" X 15" bolt as described above with a standard 3" Cast Iron Harrison Monument, stamped "Mason County Monument", 1.0' below the gravel surface of Decker Road and 5' South of the centerline. This corner is accepted as the best available evidence of the position of the corner.

- (1) Existing 60d spike NE Side, 18" Ash, N55°E, 92.11'
- (2) Set 60d Spike West side, 8" Elm, S02°E, 35.25'
- (3) Set 60d spike NW Side, 4" X 6" treated westerly gate post, N64°E, 60.33'
- (4) Capped Iron (PLS 17634) N35°W, 43.06'
- (6) Corner F-13, T.19N., R.16W., Set 3" Harrison cast iron monument, West, 25.54'

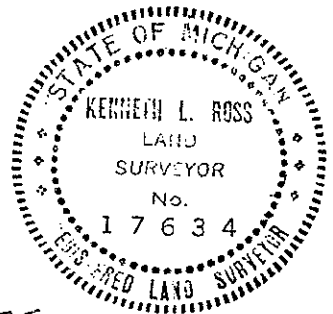

Signed by [Signature] Date Nov 4, 1999

Surveyor's Michigan License No. 17634

Peer Group Reviewed and Approved
Date: 11-04-99
[Signature]
Kenneth L. Ross
Mason County Surveyor