

DEC 29 1998

LAND CORNER RECORDATION CERTIFICATE

Filing Requirement of Act 74, Mich. P.A. 1970

SLOT 1001

For corners in

MASON (County)

Located In:

Corner Code #

- 1. Public Land Survey T 18N R 16W F-7
2. Property Controlling in Section S T R
3. Miscellaneous Property in Sec. S T R

FILED AT 2:55 O'CLOCK NOV 21 1998 MARY GOLDEN KOLASKI MASON COUNTY REGISTER OF DEEDS Register of Deeds Stamp & File Number

- 4. Lot No. Recorded Plat
5. Private Claims

I, Kenneth L. Ross, in a field survey on July 17, 1998, do hereby certify that under requirements of P.A. 74, Michigan P.A. of 1970, the corner points mentioned in lines 1 and 2 above were in conformance with regulations and rules therefore as required in the current manual of survey instructions of the United States Department of the Interior, Bureau of Land Management or by a decree of a Court of Law and/or that the corner points mentioned in lines 3, 4 and 5 above were in conformance with the rules of the Michigan Board of Land Surveyors or by a Decree of a Court of Law, established, re-established, monumented, re-monumented, recovered, found as expressed below.

Grid table with columns A-M and rows 1-13. Cell (7, G) contains a black dot.

NOTE: Not more than 4 corners, all in the same town and range, may be recorded on this certificate.

A. Description of original monument and accessories and/or subsequent restoration:

F-7 1/4 Corner for Sections 16 and 21, T18N-R16W.

1839, Sylvester Sibley, G.L.O. 16" Beech for corner, at 2634.72' (39.92 chs.)

1968, J. Borsfay, Mason Co. Road Comm. Found Cylinder Shaped Ceramic ? Surrounded by Rocks.

- #4 Tele Pole NE 54.00' (tag & nail)
#5 Apple twin SE 80.32' (tag & nail)
#6 Power Pole SW 71.38' (tag & nail)

- Mason Co. Road Comm. No Date, Tile and Stone
#1 Elm 10" S 78 W 147.80'
#2 Apple 12" S 21 E 51.70'
#3 NE corner of House S 52 1/2" W no distance given, Land Corner Record

- 1985, Ken Ross, RLS# 17634 Used existing 1/2" Re-rod in surveys, E-143 and 96398s.
#7 Tele-phone junction Box -top center- N 60 W 81.68'
#8 Power Pole N 40 E 32.80'
#9 Power Pole S 77 W 123.38'
#10 Apple 14" S 14 E 81.98'

B. Description of corner evidence found and/or method applied in restoring or reestablishing corner:

F-7 1/4 Corner for Sections 16 and 21, T18N-R16W.

On July 17, I Found a 1/2" Re-rod, 4 foot North of the Center-Line of First Street, as used by other surveyors and by me. I also found N/A associate, cap 1/2" re-rod, 33.00 feet to the South, I found no evidence to dispute the location of this corner.

- Condition of record witnesses as follows: #1 Gone #2 Gone #3 Found remains of old foundation #4 Gone
#5 Found in good condition #6 Gone #7 Found in good condition #8 Found in good condition
#9 Found in good condition #10 Found in good condition-same as #5


C. Description of monument for corner and accessories established to perpetuate locating the position of the corner:

F-7 1/4 Corner for Sections 16 and 21, T18N-R16W.

I replaced 1/2" Re-rod, in the exact location, with a Harrison cast iron monument (4" top, 18 1/2" long) stamped, MASON COUNTY MONUMENT, I set monument flush with the surface, encased in concrete. This corner is accepted as a careful and faithful re-establishment of the position of the original corner.

- Ext"BT"#7 Telephone junction box top center N 60 W 81.68'
Ext"BT"#8 Power Pole N 40 E 32.80' (60d spike in NW side of pole)
Ext"BT"#9 Power Pole S 77 W 123.38' (60d spike in SE side of pole)
Ext"BT"#10 & 5 Apple 14" S 14 E 81.98' (60d spike in SW side of tree)

Signed by [Signature] Date NOV 19 1998
Surveyor's Michigan License No. 17634

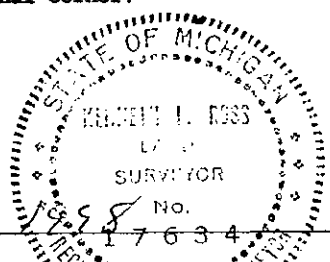

FORM APPROVED BY MICHIGAN STATE BOARD OF LAND SURVEYORS, JAN. 28, 1971 REVISED MAY 14, 1975 REVISED JAN. 1983 ADAPTED FOR WORD PROCESSING MARCH, 1993

Peer Group Reviewed and Approved Date: 11-17-98 Kenneth L. Ross Mason County Surveyor