

MAR 16 1998

LIBER -- 4 PAGE 125

SECTION

LAND CORNER RECORDATION CERTIFICATE

Filing Requirement of Act 74, Mich. P.A. 1970

For corners in
MASON
(County)

Located In: _____ Corner Code # _____


1. Public Land Survey T 18 NR 16W F-13
T _____ R _____
T _____ R _____
T _____ R _____

2. Property Controlling S _____ T _____ R _____
in Section S _____ T _____ R _____

3. Miscellaneous S _____ T _____ R _____
Property in Sec. S _____ T _____ R _____

4. Lot No. _____, Recorded Plat _____

5. Private Claims _____

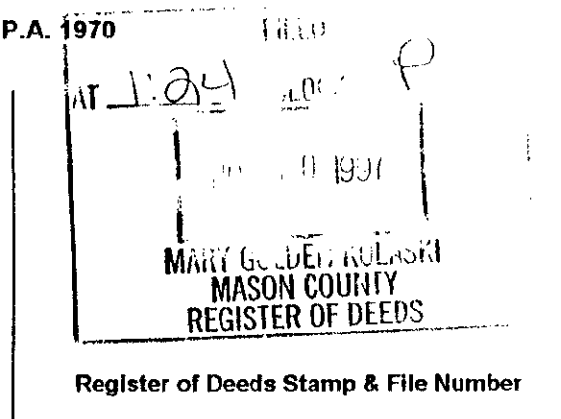

	A	B	C	D	E	F	G	H	I	J	K	L	M
1													
2	6			5			4			3		2	1
3													
4	7			8			9			10		11	12
5													
6	18			17			16			15		14	13
7													
8	19			20			21			22		23	24
9													
10	30			29			28			27		26	25
11													
12	31			32			33			34		35	36
13													

I, Sammy S. Barnett, in a field survey on Sept. 22th 19 97, do hereby certify that under requirements of P.A. 74, Michigan P.A. of 1970, the corner points mentioned in lines 1 and 2 above were in conformance with regulations and rules therefore as required in the current manual of survey instructions of the United States Department of the Interior, Bureau of Land Management or by a decree of a Court of Law and/or that the corner points mentioned in lines 3, 4 and 5 above were in conformance with the rules of the Michigan Board of Land Surveyors or by a Decree of a Court of Law; established, re-established, monumented, re-monumented, recovered, found as expressed below:

NOTE: Not more than 4 corners, all in the same town and range, may be recorded on this certificate.

A. Description of original monument and accessories and/or subsequent restoration:

F - 13 South one-quarter corner, section 33 T18N, R16W

- | | | |
|--|---|--|
| 1838 GLO survey by Mullett & Brookfields
Set post
1 Beech 10" N34E 10 lks (6.6')
2 Beech 20" N25W 28 lks (18.48') | 1879 survey by J.H. Jones
Monument not given
Identified by old dead tree stumps | 1886 survey by W.E. Metcalf
Round stone
Stumps of Government witnesses |
|--|---|--|

B. Description of corner evidence found and/or method applied in restoring or reestablishing corner:

F - 13 South one-quarter corner, section 33 T18N, R16W

On Sept. 22th 1997 I set a Standard Mason County Monument one-half way between E - 13 and G - 13 and on line between F - 1 T17N, R16W and E - 13 T18N, R16W corner falls in approximately 4' of fill, condition of witnesses is as follows:
1 Gone # 2 Gone

C. Description of monument for corner and accessories established to perpetuate locating the position of the corner:

F - 13 South one-quarter corner, section 33 T18N, R16W

On Sept 22th 1997, I accepted the set Standard Mason County Monument as a careful and faithful reestablishment of the position of the original corner, and took the following witnesses.


- # 3 Fence post N63E 50.72' set PK nail in SE side
- # 4 4" Pipe fence post S04E 32.95' , 1 of pipe
- # 5 Guy pole S40W 42.20' set PK in SE side
- # 6 Power pole # 69 N34W 43.30' set PK in NE side
- # 7 Standard Mason Co. Mon. East 4.64' (Found N 1/4 cor. sec. 4 T17N, R16W)

Corner position is in the centerline of the East-West blacktop road and approximately 6' West of the centerline of the gravel road to the North.
Corner is in a monument box.

Signed by Sammy S. Barnett

Date 11-4-97

Surveyor's Michigan License No. P S # 16923

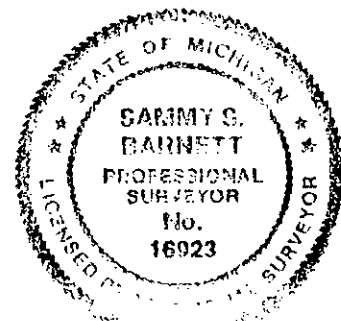

Peer Group Reviewed
and Approved
Date: Oct 2, 1997
Kenneth L. Ross
Mason County Surveyor