

DEC 29 1998

LAND CORNER RECORDATION CERTIFICATE


Filing Requirement of Act 74, Mich. P.A. 1970

SECTION  
For corners in  
MASON  
(County)

Located In:

Corner Code #

- 1. Public Land Survey T 18N R 16W G-5  
T R  
T R  
T R
- 2. Property Controlling S T R  
in Section S T R
- 3. Miscellaneous S T R  
Property in Sec. S T R

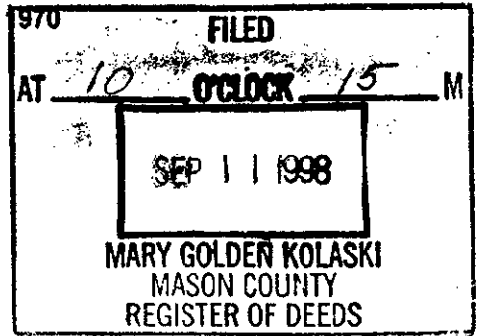

Register of Deeds Stamp & File Number

- 4. Lot No. \_\_\_\_\_ Recorded Plat \_\_\_\_\_
- 5. Private Claims \_\_\_\_\_

I, Kenneth L. Ross, in a field survey on August 25 1998, do hereby certify that under requirements of P.A. 74, Michigan P.A. of 1970, the corner points mentioned in lines 1 and 2 above were in conformance with regulations and rules therefore as required in the current manual of survey instructions of the United States Department of the Interior, Bureau of Land Management or by a decree of a Court of Law and/or that the corner points mentioned in lines 3, 4 and 5 above were in conformance with the rules of the Michigan Board of Land Surveyors or by a Decree of a Court of Law; established, re-established, monumented, re-monumented, recovered, found as expressed below:

	A	B	C	D	E	F	G	H	I	J	K	L	M
1													
2	6	5	4	3	2	1							
3													
4	7	8	9	10	11	12							
5													
6	18	17	16	15	14	13							
7													
8	19	20	21	22	23	24							
9													
10	30	29	28	27	26	25							
11													
12	31	32	33	34	35	36							
13													

NOTE: Not more than 4 corners, all in the same town and range, may be recorded on this certificate.

A. Description of original monument and accessories and/or subsequent restoration:

G-5 Section Corner for Sections 9, 10, 15 and 16, T18N-R16W.

1838, Sylvester Sibley, G.L.O.  
Set Wood Post

- #1 Beech 14" N 16 W 42 lks. (27.72')
- #2 Beech 10" S 28 E 34 lks. (22.44')

1976, Ken Ross, RLS #17634

Found 5/8" Iron in monument box  
(file no. E-72, E-88, 95120s. & 96294S.)

B. Description of corner evidence found and/or method applied in restoring or reestablishing corner:

G-5 Section Corner for Sections 9, 10, 15 and 16, T18N-R16W.

On August 25, 1998, I found a 3/4" Iron Pipe inside an existing monument box, 7.0 feet East of the center-line of Custer Road. I found no evidence to dispute this location for the corner.

Condition of record witnesses are as follows: #1 Gone #2 Gone

C. Description of monument for corner and accessories established to perpetuate locating the position of the corner:

G-5 Section Corner for Sections 9, 10, 15 and 16, T18N-R16W.

I replaced 3/4"x 18" long Iron Rod, with a 5/8" x 24" long Re-Rod with aluminum cap, stamped MASON COUNTY MONUMENT, set inside the existing monument box. This corner is accepted as a careful and faithful re-establishment of the position of the original corner. I took four new witnesses.

- #3 Power Pole N 23 E 89.65' (16p nail with M.D.O.T. shiner in NW side of pole)
- #4 Power Pole N 88 W 70.27' (16p nail with M.D.O.T. shiner in North side of pole)
- #5 Power Pole S 30 E 71.50' (16p nail with M.D.O.T. shiner in NE side of pole)
- #6 Maple 21" S 28 W 68.03' (set 60 spike in SE side of tree)

Signed by Kenneth L. Ross

Date Sept 8 - 1998

Surveyor's Michigan License No. 17634

FORM APPROVED BY MICHIGAN STATE BOARD OF LAND SURVEYORS, JAN. 28, 1971  
REVISED MAY 14, 1978  
REVISED JAN. 1983  
ADAPTED FOR WORD PROCESSING MARCH, 1983

Peer Group Reviewed  
and Approved  
Date 9-8-98  
Kenneth L. Ross  
Mason County Surveyor