

SURVEY & REMONUMENTATION

FEB 08 2000

SECTION

LAND CORNER RECORDATION CERTIFICATE
Filing Requirement of Act 74, Mich. P.A. 1970

For corners In: Located In: Corner Code #

Mason County

1. Public Land Survey T 18N R 16W H-9

T _____ R _____

T _____ R _____

T _____ R _____


2. Property Controlling S _____ T _____ R _____
in Section S _____ T _____ R _____

3. Miscellaneous S _____ T _____ R _____

Property in Sec. S _____ T _____ R _____

4. Lot No. _____, Recorded Plat _____

5. Private Claims _____

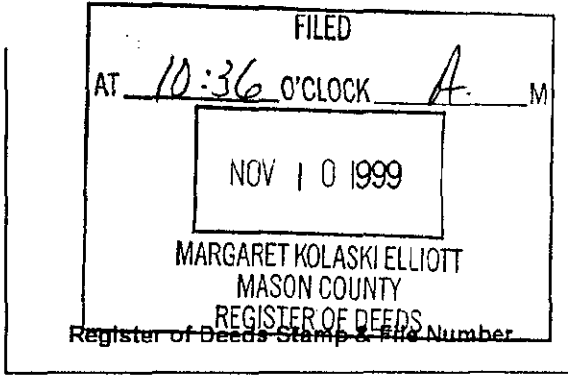

	A	B	C	D	E	F	G	H	I	J	K	L	M
2	6	5	4	3	2	1							
3													
4	7	8	9	10	11	12							
5													
6	18	17	16	15	14	13							
7													
8	19	20	21	22	23	24							
9													
10	30	29	28	27	26	25							
11													
12	31	32	33	34	35	36							
13													

I, Kenneth L. Ross, in a field survey on October 9, 1999, Do hereby certify that under requirements of P.A.74, Michigan P.A. of 1970, the corner points mentioned in lines 1 and 2 above were in conformance with regulations and rules therefore as required in the current manual of survey instructions of the United States Department of the Interior, Bureau of Land Management or by a decree of a Court of Law and/or that the corner points mentioned in lines 3, 4 and 5 above were in conformance with the rules of the Michigan Board of Land Surveyors or by a Decree of a Court of Law; established, re-established, monumented, re-monumented, recovered, found as expressed below:

NOTE: Not more than 4 corners, all in the same town and range, may be recorded on this certificate.

A. Description of original monument and accessories and/or subsequent restoration:

S 1/4 Corner Section 22, T.18N., R.16W.,

GLO Sylvester Sibley, 1838
"Hemlock for Corner"
No Witnesses Given

W.E. Metcalf, Book 1, page 73
"Identified Corner by Old Govt. Marker"
No Witnesses Given
Distance East to I-9, 2620.86'
Distance West to G-9, 2638.02'

K.L. Ross, 1985, Act 132, and LCRC Liber 2, page 107.
"Set 1" X 4' pipe from prorating Distances on Metcalf Survey"
(1) 10" White Pine, S67°W, 80.33'
(2) Most Westerly SW Corner of House Foundation, S73°E, 149.75'
15' North of brow of Hill on E-W Fence Line
Distance North to H-7, 5172.78'

K.L. Ross, Act 132, 1994, "Set 1/2" capped Iron by proportionate measurement from Metcalf Survey."

(3) NW Cor. Pole Build. S82°E, 72.41'
(4) SW Cor. Pole Build. S76°E, 66.42'
(5) 4" White Pine, N56°W, 28.64'
(6) 4" White Pine, S12°E, 11.92'

(Added this information 10/21/99)
Norman L. Ochs, LCRC, Liber 4, page 283
October 1st, 1999 "Accepted 1/2" capped iron"
Witnesses (4) thru (6) given.
(7) 6" Red Oak, N15°E, 41.04' spike with tag, NW side of tree

Gordon Bonney, Act 132, Liber 442, Page 875, Tied this corner.
No Witnesses Given.
Distance West to G-9, 2612.28'

B. Description of corner evidence found and/or method applied in restoring or reestablishing corner:

S 1/4 Corner Section 22, T.18N., R.16W.,

I found a 1/2" X 24" Capped Iron # 17634 as described by K.L. Ross, above. Witnesses (1) has been destroyed. Witnesses (2) through (6) are standing and in good condition. I could find no other evidence to dispute the location of this corner.

C. Description of monument for corner and accessories established to perpetuate locating the position of the corner:

S 1/4 Corner Section 22, T.18N., R.16W.,

I replaced the 1/2" X 24" capped iron in its exact location with a 5/8" X 24" iron re-rod with a standard 3" aluminum cap stamped "Mason County Monument", flush with the ground surface and accepted this corner as the best available evidence of the re-establishment of the Original Corner.

- (2) Most Westerly SW Corner of House Foundation, S73°E, 149.78'
- (3) NW Cor. Pole Build. S82°E, 72.41'
- (4) SW Cor. Pole Build. S76°E, 66.42'
- (5) Existing 60 d spike NE side of 6" White Pine, N56°W, 28.64'
- (6) Existing 60 d spike SW side of 6" White Pine, S12°E, 11.92'
- (7) Existing 60d spike NW side of 8" Red Oak, N02°E, 40.96'
- (8) 4" pipe filled with concrete, North, 0.60'

LIBER 4 PAGE 294

Signed by [Signature] Date Nov. 4, 1999

Surveyor's Michigan License No. 17634

Approved by Peer Review Group on Nov. 4, 1999
Kenneth L. Ross, County Representative [Signature]

