

SURVEY & REMONUMENTATION

MAR 16 1998


LIBER -- 4 PAGE 127

SECTION

LAND CORNER RECORDATION CERTIFICATE

Filing Requirement of Act 74, Mich. P.A. 1970

For corners in <u>MASON</u> (County)	Located In:	Corner Code #
1. Public Land Survey	T 18 N R 16W	H-13
	T _____ R _____	_____
	T _____ R _____	_____
	T _____ R _____	_____
2. Property Controlling In Section	S _____ T _____ R _____	_____
	S _____ T _____ R _____	_____
3. Miscellaneous Property in Sec.	S _____ T _____ R _____	_____
	S _____ T _____ R _____	_____
4. Lot No. _____, Recorded Plat _____		
5. Private Claims _____		

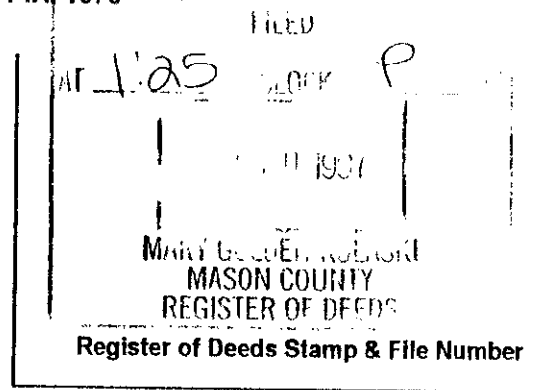

	A	B	C	D	E	F	G	H	I	J	K	L	M
1													
2	6		5		4		3		2		1		
3													
4	7		8		9		10		11		12		
5													
6	18		17		16		15		14		13		
7													
8	19		20		21		22		23		24		
9													
10	30		29		28		27		26		25		
11													
12	31		32		33		34		35		36		
13													

I, Sammy S. Barnett, in a field survey on Sept. 15th 19 97, do hereby certify that under requirements of P.A. 74, Michigan P.A. of 1970, the corner points mentioned in lines 1 and 2 above were in conformance with regulations and rules therefore as required in the current manual of survey instructions of the United States Department of the Interior, Bureau of Land Management or by a decree of a Court of Law and/or that the corner points mentioned in lines 3, 4 and 5 above were in conformance with the rules of the Michigan Board of Land Surveyors or by a Decree of a Court of Law; established, re-established, monumented, re-monumented, recovered, found as expressed below:

NOTE: Not more than 4 corners, all in the same town and range, may be recorded on this certificate.

A. Description of original monument and accessories and/or subsequent restoration:

H - 13 South one-quarter corner, section 34 T18N, R16W

1838 GLO survey by Mullett & Brookfield Set post # 1 W. Oak 18" N52W 20 lks (13.2') # 2 W. Pine 14" N20E 11 lks (7.26')	1879 survey by J.H. Jones Identified by old tree set stake	1886 survey by W.E. Metcalf Monument not given Found old oak lying down marks visable # 3 Pine stump 20" N4W 19 lks (12.54') # 4 Pine stump 24" N36E 26 lks (17.16')
--	--	---

B. Description of corner evidence found and/or method applied in restoring or reestablishing corner:

H - 13 South one-quarter corner, section 34 T18N, R16W

On Sept. 15th 1997 I set a Standard Mason County Monument one-half way between G - 13 and I - 13 and on line between I - 13 T18N, R16W and G - 1 T17N, R16W, the condition of the witnesses is as follows,
1 Gone # 2 Gone # 3 Gone # 4 Gone


C. Description of monument for corner and accessories established to perpetuate locating the position of the corner:

H - 13 South one-quarter corner, section 34 T18N, R16W

On Sept 15th 1997, I accepted the set Standard Mason County Monument as a careful and faithful reestablishment of the position of the original corner, and took the following witnesses.

5 W. Cherry 6" S74E 32.78' set 60d spike in North side
6 Maple 6" S87W 13.89' set 60d spike in North side
7 Maple 14" N27W 52.27' set 60d spike in Northeast side
8 Set 1/2" rebar N56E 57.68' set old steel fence post by iron
9 Standard Mason Co. Mon. East 6.93'

Centerline of gravel road is approximately 13' North corner falls at base of sharp road cut.

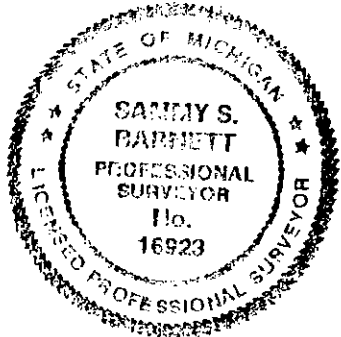

Signed by Sammy S. Barnett Date 11-4-97
Surveyor's Michigan License No. P S # 16923

Peer Group Reviewed
and Approved
Date: Oct 2, 1997
Kenneth L. Ross
Mason County Surveyor