

DEC 9 1998

LAND CORNER RECORDATION CERTIFICATE

Filing Requirement of Act 74, Mich. P.A. 1970

SECTION

For corners in

MASON
(County)

Located in:

Corner Code #

1. Public Land Survey

T 18N R 16W

I-7

T R

T R

T R

S T R

S T R

S T R

S T R

2. Property Controlling in Section

3. Miscellaneous Property in Sec.

4. Lot No. Recorded Plat

5. Private Claims

FILED
AT 10 O'CLOCK 20 A.M.
11
MARY GOLDEN KOLASH

Register of Deeds Stamp & File Number

I, Kenneth L. ROSS, in a field survey on August 24 19 98, do hereby certify that under requirements of P.A. 74, Michigan P.A. of 1970, the corner points mentioned in lines 1 and 2 above were in conformance with regulations and rules therefore as required in the current manual of survey instructions of the United States Department of the Interior, Bureau of Land Management or by a decree of a Court of Law and/or that the corner points mentioned in lines 3, 4 and 5 above were in conformance with the rules of the Michigan Board of Land Surveyors or by a Decree of a Court of Law, established, re-established, monumented, re-monumented, recovered, found as expressed below:

NOTE: Not more than 4 corners, all in the same town and range, may be recorded on this certificate.

A. Description of original monument and accessories and/or subsequent restoration:

I-7 Section Corner for Sections 14, 15 22 and 23, T18N-R16W.

1838, Sylvester Sibley, G.L.O.

Set Wood Post

#1 Beech 14" S 41 W 11 lks. (7.26')

#2 Sugar Maple 10" N 43 E 15 lks. (9.90')

1977, Ken Ross, RLS #17634

found 3/4" Iron Pipe

(file no. E-92)

1935, Robert Lunde, Mason Co. Surveyor

Stone 8" & plowshare

#3 Elm 16" N 26-15 W 63.80'

#4 Elm 10" N 07 W 73.20'

(book 2, page 323)

B. Description of corner evidence found and/or method applied in restoring or reestablishing corner:

I-7 Section Corner for Sections 14, 15 22 and 23, T18N-R16W.

On August 24, 1998, I found 3/4" iron Pipe, a plow share and stone, 10 feet South of the center-line of first Street (gravel road). I found no evidence to dispute this location for the corner.

Condition of record witnesses are as follows; #1 Gone #2 Gone #3 Gone #4 Gone

C. Description of monument for corner and accessories established to perpetuate locating the position of the corner:

I-7 Section Corner for Sections 14, 15 22 and 23, T18N-R16W.

I replaced 3/4" Iron Pipe, plowshare and stone, in the exact location of Iron Pipe, with a Harrison cast iron monument, stamped MASON COUNTY MONUMENT, I set monument 0.5 feet below road surface, cap with concrete. This corner is accepted as a careful and faithful re-establishment of the position of the original concrete. I took four new witnesses.

#5 Sugar Maple 24" S 84 E 105.65' (P.K. nail in NE side of tree)

#6 Power Pole S 45 W 43.50' (P.K. nail in NW side of pole)

#7 Tele-phone pole cut-off South 25.57' (P.K. nail in west side of pole)

#8 Stop Sign N 35 W 66.40' (center of post)


Note: I measured reference distances from I-7 to I-6 at 2652.76 feet & from I-7 to H-7 at 2657.22 feet.

igned by *Kenneth L. Ross*

Date Sept. 8, 1998

urveyor's Michigan License No. 17634

FORM APPROVED BY MICHIGAN STATE BOARD OF LAND SURVEYORS, JAN 26, 1971
REVISED MAY 14, 1978
REVISED JAN, 1983
ADAPTED FOR WORD PROCESSING MARCH, 1993

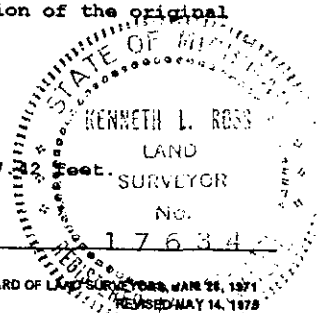

Part Group Reviewed

Date: 9-8-98
Kenneth L. Ross