


FEB 08 2000

SECTION

LAND CORNER RECORDATION CERTIFICATE
Filing Requirement of Act 74, Mich. P.A. 1970

For corners In: Located In: Corner Code #
 Mason County

- 1. Public Land Survey T 18N R 16W I-8
- 2. Property Controlling in Section S T R
- 3. Miscellaneous S T R
- Property in Sec. S T R

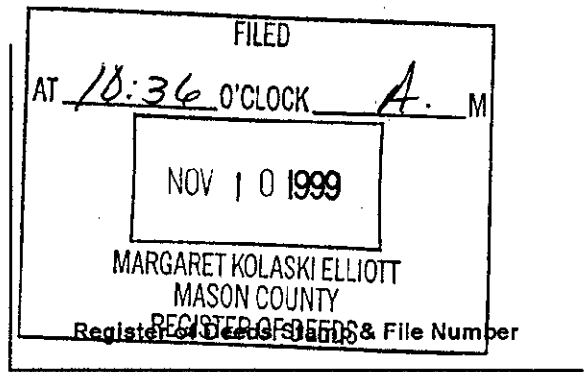

- 4. Lot No. _____, Recorded Plat _____
- 5. Private Claims _____

	A	B	C	D	E	F	G	H	I	J	K	L	M
1													
2	6	5	4	3	2	1							
3													
4	7	8	9	10	11	12							
5													
6	18	17	16	15	14	13							
7													
8	19	20	21	22	23	24							
9													
10	30	29	28	27	26	25							
11													
12	31	32	33	34	35	36							
13													

I, Kenneth L. Ross, in a field survey on September 11, 1999, Do hereby certify that under requirements of P.A.74, Michigan P.A. of 1970, the corner points mentioned in lines 1 and 2 above were in conformance with regulations and rules therefore as required in the current manual of survey instructions of the United States Department of the Interior, Bureau of Land Management or by a decree of a Court of Law and/or that the corner points mentioned in lines 3, 4 and 5 above were in conformance with the rules of the Michigan Board of Land Surveyors or by a Decree of a Court of Law; established, re-established, monumented, re-monumented, recovered, found as expressed below:

NOTE: Not more than 4 corners, all in the same town and range, may be recorded on this certificate.

A. Description of original monument and accessories and/or subsequent restoration:

¼ Corner Common to Sections 22 and 23, T.18N., R.16W.,

GLO Sylvester Sibley, 1838
 Set ¼ sec. post

- (1) Beech, 10", N61°E, 5 links, (3.30')
- (2) Beech, 10", S80°W, 18 links, (11.88')

- K.L. Ross, 1983, Act 132, and LCRC Liber 2, page 107 * Set 1" pipe, 0.8' South of Railroad Tie
- (3) 20" Maple, N10°W, 36.50'
- (4) 24" Beech, West 16.74'
- (5) SW Corner House, NE, 35.53'

Norman L. Ochs, LCRC, Liber 2, page 282 Completed his survey June 8, 1999, but, recorded LCRC Oct. 1st, 1999 after I completed my field work. States "removed pipe set 2" X 30" Galv. Pipe. Witnesses (3) thru (5) given. (6) 12" Maple, N60°W, 40.00'

B. Description of corner evidence found and/or method applied in restoring or reestablishing corner:

¼ Corner Common to Sections 22 and 23, T.18N., R.16W.,

I found a USFS 2 ½" Pipe with 3" Brass Cap, Unrecorded at this time "It is my belief that this was set during the summer of 1999 by the USFS Survey Crew and they have not recorded an LCRC on this corner as of this date." It is also my belief that the USFS Survey crew replaced the 1" pipe as described above by K.L. Ross, with this 2 ½" pipe and brass disk". Witnesses (1) and (2) have been destroyed. Witnesses (3) through (5) are standing and in good condition.

C. Description of monument for corner and accessories established to perpetuate locating the position of the corner:

¼ Corner Common to Sections 22 and 23, T.18N., R.16W.,


I left the existing 2 ½" pipe and Brass Cap in place and accepted this corner as the best available evidence of the re-establishment of the original Corner.

- (3) Existing 60d spike East side of 26" Maple, N10°W, 36.50'
- (4) Existing 60d spike North side 36" Beech, West 16.71'
- (5) SW Corner House, N30°E, 35.37"
- (6) Existing 60d spike, NE side 12" Maple, N60°W, 40.00'
- (7) Center of Rail Road Tie, North, 1.0'

Signed by [Signature] Date Nov. 4, 1999

Surveyor's Michigan License No. 17634

Approved by Peer Review Group on Nov. 4, 1999
 Kenneth L. Ross, County Representative [Signature]

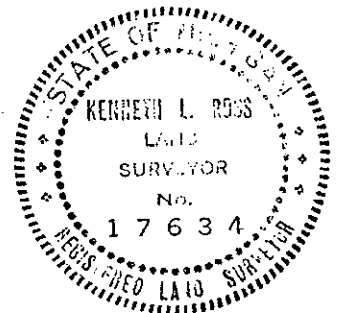

FORM APPROVED BY MICHIGAN STATE BOARD OF LAND SURVEYORS, JAN. 28, 1971;
 REVISED MAY 14, 1975
 REVISED JAN, 1983
 ADAPTED FOR WORD PROCESSING MARCH, 1993