

FEB 08 2000

SECTION

LAND CORNER RECORDATION CERTIFICATE

Filing Requirement of Act 74, Mich. P.A. 1970


For corners In: Located In: Corner Code #
 Mason County

1. Public Land Survey T 18N R 16W I-9
 T _____ R _____
 T _____ R _____
 T _____ R _____

2. Property Controlling S _____ T _____ R _____
 in Section S _____ T _____ R _____

3. Miscellaneous S _____ T _____ R _____

Property in Sec. S _____ T _____ R _____

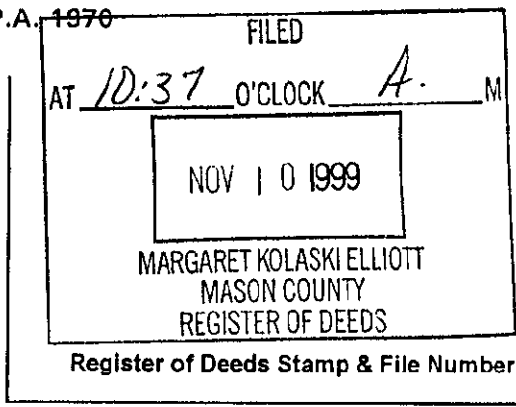

4. Lot No. _____, Recorded Plat _____
 5. Private Claims _____

	A	B	C	D	E	F	G	H	I	J	K	L	M
1													
2	6	5	4	3	2	1							
3													
4	7	8	9	10	11	12							
5													
6	18	17	16	15	14	13							
7													
8	19	20	21	22	23	24							
9													
10	30	29	28	27	26	25							
11													
12	31	32	33	34	35	36							
13													

I, Kenneth L. Ross, in a field survey on September 11, 1999, Do hereby certify that under requirements of P.A. 74, Michigan P.A. of 1970, the corner points mentioned in lines 1 and 2 above were in conformance with regulations and rules therefore as required in the current manual of survey instructions of the United States Department of the Interior, Bureau of Land Management or by a decree of a Court of Law and/or that the corner points mentioned in lines 3, 4 and 5 above were in conformance with the rules of the Michigan Board of Land Surveyors or by a Decree of a Court of Law; established, re-established, monumented, re-monumented, recovered, found as expressed below:

NOTE: Not more than 4 corners, all in the same town and range, may be recorded on this certificate.

A. Description of original monument and accessories and/or subsequent restoration:

Corner Common To Sections 22, 23, 26 and 27, T. 18N., R. 16W.,

GLO Sylvester Sibley, 1838 "Set Post Cor. Secs. 22, 23, 26 and 27" (1) Sugar, 12", S21°W, 31 links (20.46') (2) Maple, 12", N21°E, 10 links (6.60')	James Jones, 1884, Book 1, page 173 "Identified corner by Govt. Witnesses" No Witnesses Given. Distance East to J-9, 2608.65' Distance South to I-10, 2605.02'	K.L. Ross, Act 132, 1980, "Found USFS Monument" No Witnesses Given. Distance South to I-10, 2643.24'
W.E. Metcalf, undated, Book 1, page 73 "Identified by Government Marker" No Witnesses Given Distance West to H-9, 2620.86' Distance South to I-10, 2611.29'	K.B. Stephens, 1967, Dwg. E-53 "Set ¾" iron pipe" (3) 6" poplar, N29°W, 5.1' (4) 5" poplar, N5°E, 15.3' (5) 6" poplar, N89°W, 36.9' Distance South to I-10, 2643.62'	K.L. Ross, Act 132, 1994 "Existing USFS Monument" No Witnesses Given. Distance West to I-8, 2614.89'

B. Description of corner evidence found and/or method applied in restoring or reestablishing corner:

Corner Common To Sections 22, 23, 26 and 27, T. 18N., R. 16W.,

I found a USFS 5" square Concrete Monument with a 3" Brass Disk. Witnesses (1) through (5) have been destroyed. I found no other evidence to dispute the location of this corner.

Note: Stephens ¾" iron pipe as described above was proved to have been set in error and the USFS Monument found in 1980 was also in error and has been moved to its present location.

C. Description of monument for corner and accessories established to perpetuate locating the position of the corner:

Corner Common To Sections 22, 23, 26 and 27, T. 18N., R. 16W.,

I left the existing 5" square USFS Concrete Monument with 3" Brass Disk in place and accepted this corner as the best available evidence of the re-establishment of the Original Corner.

(6) Existing 10" Bolt Spike NW side of 8" Red Oak, N37°W, 60.15'
 (7) Existing 10" Bolt Spike East side of 12" White Pine, N26°W, 73.11'
 (8) Treated 4" X 4" Post, Nail on South side, West 2.0'
 (9) Existing 10" Bolt Spike, east side 30" Red Oak, S17°W, 98.18'
 (10) Set 60d spike NE side of 8" Red Oak, S35°E, 31.92'

Signed by [Signature] Date Nov. 4, 1999

Surveyor's Michigan License No. 17634

Approved by Peer Review Group on Nov. 4, 1999
 Kenneth L. Ross, County Representative [Signature]

