

**SURVEY &  
REMONUMENTATION**

DEC 18 1995

**COMMISSION**

**LAND CORNER RECORDATION CERTIFICATE**

Filing Requirement of Act 74, Mich. P.A. 1970


For corners in

MASON  
(County)

Located In:

Corner Code #

- |                                       |                         |       |
|---------------------------------------|-------------------------|-------|
| 1. Public Land Survey                 | T 18 N R 16 W           | I-11  |
|                                       | T _____ R _____         | _____ |
|                                       | T _____ R _____         | _____ |
|                                       | T _____ R _____         | _____ |
| 2. Property Controlling in Section    | S _____ T _____ R _____ | _____ |
|                                       | S _____ T _____ R _____ | _____ |
| 3. Miscellaneous Property in Sec.     | S _____ T _____ R _____ | _____ |
|                                       | S _____ T _____ R _____ | _____ |
| 4. Lot No. _____, Recorded Plat _____ |                         |       |
| 5. Private Claims _____               |                         |       |

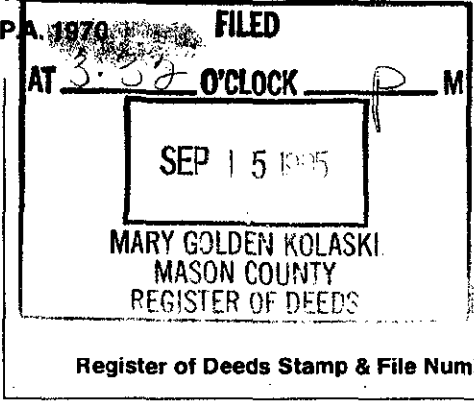

	A	B	C	D	E	F	G	H	I	J	K	L	M
2	6		5		4		3		2		1		
3													
4	7		8		9		10		11		12		
5													
6	18		17		16		15		14		13		
7													
8	19		20		21		22		23		24		
9													
10	30		29		28		27		26		25		
11													
12	31		32		33		34		35		36		
13													

I, Sammy S. Barnett, in a field survey on \_\_\_\_\_, 19\_\_\_\_, do hereby certify that under requirements of P.A. 74, Michigan P.A. of 1970, the corner points mentioned in lines 1 and 2 above were in conformance with regulations and rules therefore as required in the current manual of survey instructions of the United States Department of the Interior, Bureau of Land Management or by a decree of a Court of Law and/or that the corner points mentioned in lines 3, 4 and 5 above were in conformance with the rules of the Michigan Board of Land Surveyors or by a Decree of a Court of Law; established, re-established, monumented, re-monumented, recovered, found as expressed below:

**NOTE: Not more than 4 corners, all in the same town and range, may be recorded on this certificate.**

**A. Description of original monument and accessories and/or subsequent restoration:**

I-11 Section Corner for Sections, 26, 27, 34 and 35, T18N, R16W.

1838, Sylvester Sibley, D.S., G.L.O.  
Set Wood Post  
#1 Beech 16" S 09° W 241ks. (15.84')  
#2 Beech 14" S 62° E 251ks. (16.50')

1884, James Jones, Dep. Co. Surv.  
Found Gov't. Stake & Witnesses

1886, W.E. Metcalf, Dep. Co. Surv.  
Found Gov't. Stake & Witnesses OK

1903, R.O. Towns, Co. Surv.  
Found or Set Stone & Iron  
No now witnesses

1993, Ken Ross, M.C.S.  
Found 3/4" Iron Pipe

#3 Power Pole N10°W 102.00'  
#4 Tele-Pole N45°E 32.30'  
#5 Road Name sign  
S53°E 45.10'

1967, Ken Stephens  
Set 3/4" Iron Pipe  
File No. E-53, Fld Bk 34

**B. Description of corner evidence found and/or method applied in restoring or reestablishing corner:**

I-11 Section Corner for Sections 26, 27, 34 and 35, T18N, R16W.

On August 8, 1995 I found a 3/4" Iron Pipe at the intersection of Wilson Road and Stephens Road, just below gravel road surface, I found no other Irons or Marker or any evidence to dispute this location.

Condition of Record Witnesses is; #1 Gone #2 Gone #3 Found in good cond. #4 Found cut off, still useable. #5 Found in good cond.

**C. Description of monument for corner and accessories established to perpetuate locating the position of the corner:**

I-11 Section Corner for Sections 26, 27, 34 and 35, T18N, R16W.


I replaced the 3/4" Iron Pipe with a 5/8" Re-Rod 24" long with an aluminum cap, stamped Manson County Monument Set Re-Rod 1.0 feet below the surface (gravel) of the road, and is accepted as a careful and faithful reestablishment of the position of the original corner.

- OBT #3 Power Pole N 10° W 102.00' (60d spike in the NE side of Pole)
- OBT #4 Tele-Pole N 45° E 32.30' (60d spike in the SE side of Pole)
- OBT #5 Road Name Sign S 53° E 45.10'
- Power Pole S 18° E 87.26' (60d spike in the SW side of Pole)

Signed by Sammy S. Barnett  
Surveyor's Michigan License No. 16923

Date 9-8-95

Peer Group Reviewed and Approved  
Date: 9-12-95  
Kenneth L. Ross  
Mason County Surveyor

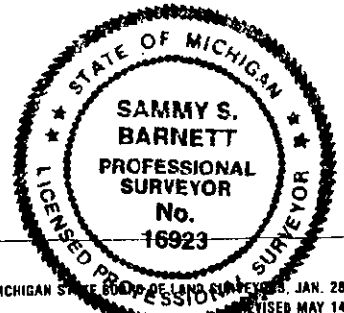

FORM APPROVED BY MICHIGAN BOARD OF LAND SURVEYORS, JAN. 28, 1971  
REVISED MAY 14, 1975  
REVISED JAN., 1983

~~LIBER~~ ~~3 PAGE 284~~

LIBER 3 PAGE 284