

SURVEY & REMONUMENTATION

MAR 16 1998

LIBER -- 4 PAGE 128

LAND CORNER RECORDATION CERTIFICATE

Filing Requirement of Act 74, Mich. P.A. 1970


SECTION

For corners in MASON Located In: _____ Corner Code # _____
 (County)

1. Public Land Survey T 18 NR 16 W I-13
 T _____ R _____
 T _____ R _____
 T _____ R _____

2. Property Controlling S _____ T _____ R _____
 in Section S _____ T _____ R _____

3. Miscellaneous S _____ T _____ R _____
 Property in Sec. S _____ T _____ R _____

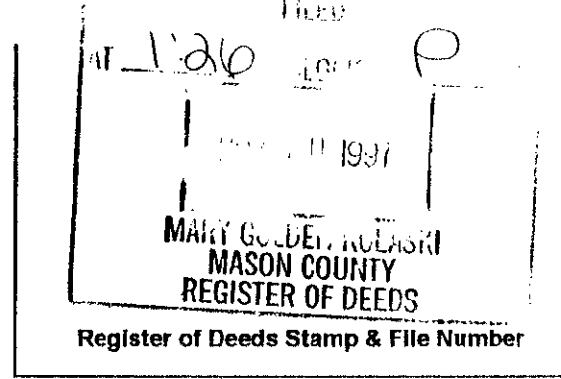

4. Lot No. _____, Recorded Plat _____
 5. Private Claims _____

	A	B	C	D	E	F	G	H	I	J	K	L	M
1													
2	6	5	4	3	2	1							
3													
4	7	8	9	10	11	12							
5													
6	18	17	16	15	14	13							
7													
8	19	20	21	22	23	24							
9													
10	30	29	28	27	26	25							
11													
12	31	32	33	34	35	36							
13													

I, Sammy S. Barnett, in a field survey on Sept. 12th 19 97, do hereby certify that under requirements of P.A. 74, Michigan P.A. of 1970, the corner points mentioned in lines 1 and 2 above were in conformance with regulations and rules therefore as required in the current manual of survey instructions of the United States Department of the Interior, Bureau of Land Management or by a decree of a Court of Law and/or that the corner points mentioned in lines 3, 4 and 5 above were in conformance with the rules of the Michigan Board of Land Surveyors or by a Decree of a Court of Law; established, re-established, monumented, re-monumented, recovered, found as expressed below:

NOTE: Not more than 4 corners, all in the same town and range, may be recorded on this certificate.

A. Description of original monument and accessories and/or subsequent restoration:

I - 13 Corner common to sections 34 & 35 T18N, R16W

1838 GLO survey by Mullett & Brookfield Set post
 # 1 Beech 10" N72E 10 lks (6.6')
 # 2 Beech 10" N10W 20 lks (13.2')

1886 survey by W. Metcalf Dep. Co. Surveyor Found old witnesses for section corner
 # 3 Pine stump 20" S50.30W 28 lks (18.48')
 # 4 Pine stump 26" N18W 25 lks (16.5')

1879 survey by J. H. Jones Identified by old trees, set stake
 1996 survey by S. Barnett, not recorded, found 1/2' rebar, no witnesses given.

B. Description of corner evidence found and/or method applied in restoring or reestablishing corner:

I - 13 Corner common to sections 34 & 35 T18N, R16W

On Sept. 12th 1997, I found an existing 1/2" rebar in the centerline of the East-West gravel road and on line with the remains of a very old down fence to the North, condition of the existing witnesses are as follows,

1 Gone # 2 Gone # 3 Gone # 4 Gone

C. Description of monument for corner and accessories established to perpetuate locating the position of the corner:


I - 13 Corner common to sections 34 & 35 T18N, R16W

On Sept 12th 1997, I replaced the found 1/2" rebar with a Standard Mason County Monument, and accepted this as the best available evidence of the position of the original corner, and took the following witnesses.

- # 5 Spruce 6" N51E 53.43' set 60d spike in NW side
- # 6 1/2" iron S10E 33.85'
- # 7 Ash 4" S37W 33.71' set 60d spike in SE side
- # 8 Beech 16" N30'w 57.94' set 60d spike in SW side
- # 9 Standard Mason County Monument East 7.26' (Corner common to sections 2 & 3 T17N, R16W)

Corner position falls in the centerline of the East-West gravel road and in line with the remains of a very old fence line to the North.

Signed by Sammy S. Barnett Date 11-4-97
 Surveyor's Michigan License No. P S # 16923

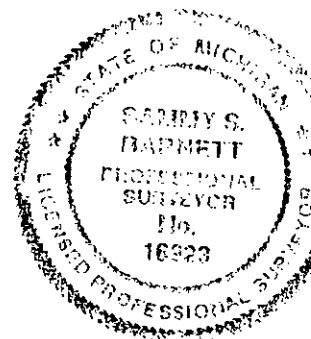

Peer Group Reviewed and Approved
 Date: Oct 2, 1997
Kenneth L. Ross
 Mason County Surveyor