

SURVEY & REMONUMENTATION

FEB 08 2000

LAND CORNER RECORDATION CERTIFICATE


Filing Requirement of Act 74, Mich. P.A. 1970

SECTION

For corners in MASON
(County)

Located In: _____ Corner Code # _____

- 1. Public Land Survey T 18N R 16W J-1
- T _____ R _____
- T _____ R _____
- T _____ R _____
- 2. Property Controlling S _____ T _____ R _____
- in Section S _____ T _____ R _____
- 3. Miscellaneous S _____ T _____ R _____
- Property in Sec. S _____ T _____ R _____

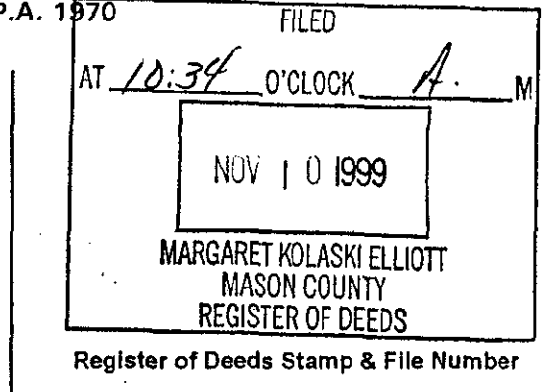

- 4. Lot No. _____, Recorded Plat _____
- 5. Private Claims _____

I, Kenneth L. Ross, in a field survey on August 28, 1999, do hereby certify that under requirements of P.A. 74, Michigan P.A. of 1970, the corner points mentioned in lines 1 and 2 above were in conformance with regulations and rules therefore as required in the current manual of survey instructions of the United States Department of the Interior, Bureau of Land Management or by a decree of a Court of Law and/or that the corner points mentioned in lines 3, 4 and 5 above were in conformance with the rules of the Michigan Board of Land Surveyors or by a Decree of a Court of Law; established, re-established, monumented, re-monumented, recovered, found as expressed below:

	A	B	C	D	E	F	G	H	I	J	K	L	M
1													
2	6	5	4	3	2	1							
3													
4	7	8	9	10	11	12							
5													
6	18	17	16	15	14	13							
7													
8	19	20	21	22	23	24							
9													
10	30	29	28	27	26	25							
11													
12	31	32	33	34	35	36							
13													

NOTE: Not more than 4 corners, all in the same town and range, may be recorded on this certificate.

A. Description of original monument and accessories and/or subsequent restoration:
J-1, N ¼ Corner Section 2, T.18N., R.16W.,
Corner not set by GLO

R.O. Towns, 1903, Book 2, page 100
And Book 4, page 116, "Planted 1/4
Post on Line by measurement"
No Witnesses give.
Distance West to I-1, 2632.08'
Distance East to K-1, 2632.08'

K.L. Ross, 1995, Act 132
"Existing Capped iron by
Bonney" Notes Corner also
used for J-13, T.19N., R.16W.,
No Witnesses given.
Distance East to K-1, 2639.23'
Distance West to I-1, 2629.16'

I found no other recorded documents in my research of this corner.

K.L. Ross, Jan, 1983, Act 132,
Ex Iron by Bonney, no witnesses
given. Distance West to I-1, 2629.16'

B. Description of corner evidence found and/or method applied in restoring or reestablishing corner:
J-1, N ¼ Corner Section 2, T.18N., R.16W.,


Found ½" X 18" re-rod with cap (unreadable), 6' South of the center-line of Decker Road. I searched the area and I could find no other evidence to dispute the location of this corner. There are some existing witness in the area, but I could find no documentation for this witness.

NOTE: This corner does not fit the single propionate measurement

C. Description of monument for corner and accessories established to perpetuate locating the position of the corner:
J-1, N ¼ Corner Section 2, T.18N., R.16W.,

I replaced the ½" X 18" re-rod in the exact location with a Standard 3" Cast Iron Harrison Monument stamped "Mason County Monument" 1 foot below the surface and 6' south of the center-line of Decker Road. This corner accepted as the best available evidence of the position of the corner.

- (1) Corner J-13, T.19N., R.16W., Set 3" Harrison cast iron monument, West, 11.97'
- (2) Set 60d spike, east side of 12" Jack Pine, S25°W, 40.46'
- (3) Set 60d spike North Side of P.P. S 88° W, 191.98'
- (4) Set 60 d spike West side of 8" X 8" treated Post, N16°W, 35.86'
- (5) Existing 60d Spike, north side of P.P. S 75°E, 89.36'
- Fence-line to North, West 12'
- Fence-line to South, West, 12'

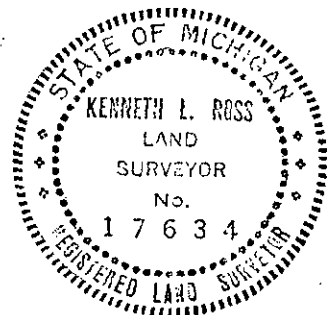

Signed by Kenneth L. Ross

Date Nov. 4, 1999

Surveyor's Michigan License No. 17634

Peer Group Reviewed and Approved
Date: 11-04-99
Kenneth L. Ross
Mason County Surveyor