


LAND CORNER RECORDATION CERTIFICATE
Filing Requirement of Act 74, Mich. P.A. 1970

For corners in

MASON (County) Located In: Corner Code #
1. Public Land Survey T 18 N R 16 W J-11
2. Property Controlling in Section S T R
3. Miscellaneous Property in Sec. S T R

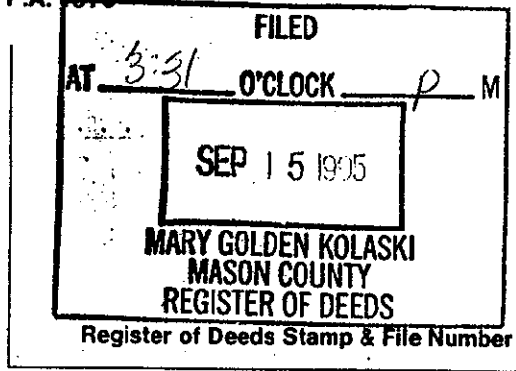

4. Lot No. , Recorded Plat
5. Private Claims

I, Sammy S. Barnett, in a field survey on 19 95 do hereby certify that under requirements of P.A. 74, Michigan P.A. of 1970, the corner points mentioned in lines 1 and 2 above were in conformance with regulations and rules therefore as required in the current manual of survey instructions of the United States Department of the Interior, Bureau of Land Management or by a decree of a Court of Law and/or that the corner points mentioned in lines 3, 4 and 5 above were in conformance with the rules of the Michigan Board of Land Surveyors or by a Decree of a Court of Law; established, re-established, monumented, re-monumented, recovered, found as expressed below:

Grid table with columns A-M and rows 2-13. A dot is marked at the intersection of column H and row 11.

NOTE: Not more than 4 corners, all in the same town and range, may be recorded on this certificate.

A. Description of original monument and accessories and/or subsequent restoration:

- J-11 1/4 Corner for Sections 26 and 35, T18N, R16W.
1838, Sylvester Sibley, D.S., G.L.O. Set Wood Post
#1 Hemlock 12" S 51° E 271ks.(17.82')
#2 Hemlock 10" N 62° W 141ks.(9.24')
1884, James Jones, Dep. Co. Surv. Set by Single proportional method Monument not given (cond.)
#3 White Pine Stump 28" S 10° W 201ks.(13.20')
1886, W.E. Metcalf, Dep. Co. Surv. Monument not given
#4 Hemlock 24" S 49° 30' W 301ks.(19.80')
#5 Pine Stump 20" S 59° E 371ks.(24.42')
1903, R.O. Towns, Co. Surv. (cont.)


B. Description of corner evidence found and/or method applied in restoring or reestablishing corner:

J-11 1/4 Corner for Section 26 and 35, T18N, R16W.
On August 8, 1995 I found a 1/2" Re-Rod set by Ken Ross, Mason County Surveyor, Corner was set on a straight line between the SW corner and the SE corner, set at record distance of 2620.20 feet(39.70 chains) from the Southwest corner of Section 26, as recorded by James Jones Dep. co. Survey, 1884, Book 1 of County Surveys. Corner fits old fence to the south within 3 feet + -, as shown on ROSS SURVEYS file No. 28791S.
Condition of Recorded Witnesses is; #1 Gone #2 Gone #3 Gone #4 Gone #5 Gone #6 Found in good cond. #7 Found in good cond.
Note; Wilson Road as been cut 15 to 20 feet at this location, thus removing historical evidence.

C. Description of monument for corner and accessories established to perpetuate locating the position of the corner:

J-11 1/4 Corner for Section 26 and 35, T18N, R16W.
I, replaced 1/2" Re-Rod with 5/8" Re-Rod, 24" long, with an aluminum cap stamped, MASON COUNTY MONUMENT Monument was placed 1.0' below the surface of Wilson Road (gravel) and 8' South of the center-line and is accepted as a careful and faithful reestablishment of the position of the original corner.
OBT #6 Power Pole N 67° E 55.68'(60d spike in SE side of Pole)
OBT #7 Poplar 10" S 16° E 28.90'(60d spike in SW side of tree)
Tw. Red Oak 4" N 61° W 97.82'(60d spike in SW side of tree)
West Gate Post S 42° W 124.00'(60d spike in NW side of Post)

Signed by Sammy S. Barnett Peer Group Reviewed and Approved Date 9-8-95
Surveyor's Michigan License No. 16923 Date: 9-12-95
Kenneth L. Ross Mason County Surveyor

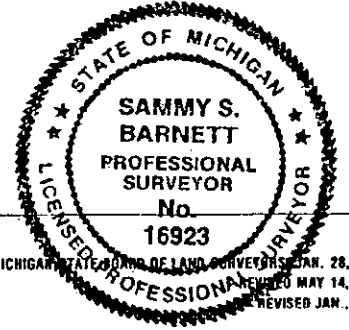

FORM APPROVED BY MICHIGAN STATE BOARD OF LAND SURVEYORS, JAN. 28, 1971 REVISED MAY 14, 1975 REVISED JAN., 1983

K-11 Section Corner for Sections 25, 26, 35 and 36, T18N, R16W.

1993, Kenneth Ross, M.C.S.

Found 1" Iron Pipe

#4 Tw. Maple S 45° E 11.72'

#5 Maple S 10° E 32.90'

#6 Tri. Maple S 77° W 36.56'

River 47 feet to the East